

15-169-00133-00-00

STATE OF KANSAS
STATE CORPORATION COMMISSION


WELL PLUGGING RECORD

Give All Information Completely
Make Required Affidavit
Mail or Deliver Report to:
Conservation Division
State Corporation Commission
211 No. Broadway
Wichita, Kansas

Saline ~~XXXX~~ County. Sec. 8 Twp. 16 Rge. 3 (E) W (W)

Location as "NE/CNW/SW" or footage from lines C NW SW
Lease Owner Kirby Petroleum Co.
Lease Name Ellen Oleen Well No. 1
Office Address 402 First National Bank Building, Pawhuska, Oklahoma
Character of Well (completed as Oil, Gas or Dry Hole) Oil
Date well completed March 13 19 53
Application for plugging filed June 8 19 65
Application for plugging approved June 9 19 65
Plugging commenced 6-9-65 19
Plugging completed 6-11-65 19
Reason for abandonment of well or producing formation Depleted.

NORTH

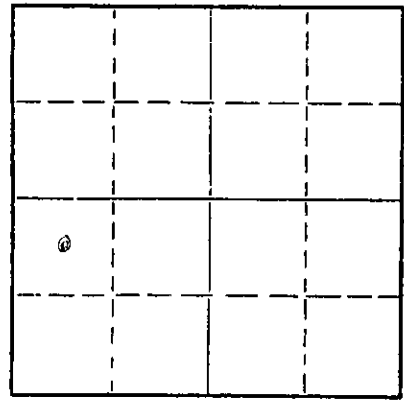

Locate well correctly on above Section Plat

If a producing well is abandoned, date of last production May 19 19 65
Was permission obtained from the Conservation Division or its agents before plugging was commenced? yes

Name of Conservation Agent who supervised plugging of this well Gilbert Toman
Producing formation Viola Depth to top 3441 Bottom 3444 Total Depth of Well 3445 Feet
Show depth and thickness of all water, oil and gas formations.

OIL, GAS OR WATER RECORDS

CASING RECORD

FORMATION	CONTENT	FROM	TO	SIZE	PUT IN	PULLED OUT
				10-3/4"	165'	None
				5-1/2"	3441'	2970'
				8-5/8"	375'	None

Describe in detail the manner in which the well was plugged, indicating where the mud fluid was placed and the method or methods used in introducing it into the hole. If cement or other plugs were used, state the character of same and depth placed, from _____ feet to _____ feet for each plug set.

Checked hole to 3445', sanded hole to 3420' and dumped 5 sacks of cement @ 3420' with dump bailer. Pulled 5 1/2" casing, bridged hole @ 280' on top of fluid, set rock bridge to 270' and dumped 25 sacks of cement. Mudded hole to 30', and ran 10 sacks of cement to base of cellar.

RECEIVED
STATE CORPORATION COMMISSION

JUN 24 1965

PLUGGING COMPLETE.

CONSERVATION DIVISION
Wichita, Kansas

(If additional description is necessary, use BACK of this sheet)

Name of Plugging Contractor KNIGHT CASING PULLING COMPANY
Address CHASE, KANSAS

STATE OF KANSAS, COUNTY OF RICE, ss.
Noel J. Knight (employee of owner) or (owner) of the above-described well, being first duly sworn on oath, says: That I have knowledge of the facts, statements, and matters herein contained and the log of the above-described well as filed and that the same are true and correct. So help me God.

(Signature) Noel J. Knight
Chase, Kansas
(Address)

SUBSCRIBED AND SWORN TO before me this 15th day of June, 1965

My commission expires May 20, 1968
Milton J. Volin Notary Public.

15-169-00133-00-00

NATIONAL ASSOCIATED PETROLEUM COMPANY

ELLEN OLEEN NO. 1 - Cen. NW SW. of 8-16S-3W

SALINE COUNTY, KANSAS

**Drilling Contractor: Exploration Drilling Co.
220 North Boston
Tulsa, Oklahoma**

**Started Rigging Up : 1-22-53
Started Drilling : 1-22-53
Completed Drilling : 3- 7-53**

**Set: 5 Joints of 10-3/4" Surface Casing
@ 164.62' W/125 Sacks of Cement.**

**Set: 113 Joints of 5-1/2"
Casing @ 3441' W/75
Sacks of Cement.**

**12 Joints of 8-5/8" Intermediate
Casing @ 375' W/125 Sacks of Cement.**

FORMATIONS

Surface	0'	278'
Shale & Lime	278	830
Lime	830	980
Lime & Shale	980	1185
Shale & Shell	1185	1520
Shale & Lime	1520	2991'
Cherty Lime	2991	3027
Lime & Chert	3027	3124
Cherty Lime	3124	3166
Lime	3166	3189
Shale	3189	3249
Lime & Shale	3249	3444 Total Depth

CERTIFICATION

This is to certify that the above and foregoing is a true, correct, and complete copy of the Driller's Log covering the Ellen Oleen No. 1 according to the records of this office and the best of my knowledge and belief.

EXPLORATION DRILLING COMPANY

By *[Signature]*
[Signature]
Notary Public

Subscribed and sworn to before me this 23rd day of March, 1953.

RECEIVED My commission expires April 25, 1954.
STATE CORPORATION COMMISSION

JUN 9 1965

CONSERVATION DIVISION
Wichita, Kansas