

STATE OF KANSAS
STATE CORPORATION COMMISSION

WELL PLUGGING RECORD


OR

FORMATION PLUGGING RECORD

Strike out upper line
when reporting plug-
ging off formations.

Give All Information Completely
Make Required Affidavit
Mail or Deliver Report to:
Conservation Division
State Corporation Commission
800 Bittling Building
Wichita, Kansas

NORTH

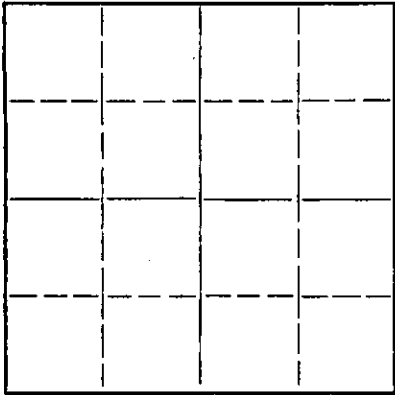

Locate well correctly on above
Section Plat

Saline County, Sec. 33 Twp. 16 Rge. (E) 3 (W)
Location as "NE 1/4 NW 1/4 SW 1/4" or footage from lines G W/2 SE/4 SE/4
Lease Owner **Falcon Seaboard Drilling Company**
Lease Name **Morris** Well No. **1**
Office Address **306 Union National Bank Building, Wichita, Kansas**
Character of Well (completed as Oil, Gas or Dry Hole) **Dry hole**
Date well completed **5-14-1945**
Application for plugging filed **5-14-1945**
Application for plugging approved **5-14-1945**
Plugging commenced **5-15-1945**
Plugging completed **5-15-1945**
Reason for abandonment of well or producing formation **dry hole**

If a producing well is abandoned, date of last production 19____
Was permission obtained from the Conservation Division or its agents before plugging was com-
menced? **yes**

Name of Conservation Agent who supervised plugging of this well **Ruel Durkee**
Producing formation _____ Depth to top _____ Bottom _____ Total Depth of Well **3555** Feet
Show depth and thickness of all water, oil and gas formations.

OIL, GAS OR WATER RECORDS


CASING RECORD

Formation	Content	From	To	Size	Put In	Pulled Out

Describe in detail the manner in which the well was plugged, indicating where the mud fluid was placed and the method or methods used in introducing it into the hold. If cement or other plugs were used, state the character of same and depth placed, from _____ feet to _____ feet for each plug set.

Hole was circulated with heavy mud each 500'. Wood and burlap plug was placed at 200' and cemented with 10 sacks cement. Hole was filled with heavy mud to 21'. Wood plug set at 21' and cemented to bottom of cellar.

PLUGGING
FILE 33-169-3W
BOOK PAGE 24-110-38

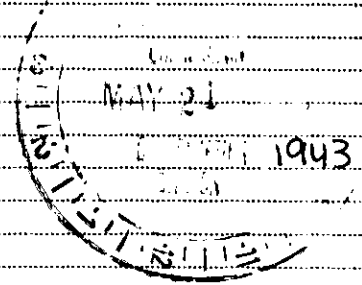

(If additional description is necessary, use BACK of this sheet)

Correspondence regarding this well should be addressed to **Falcon Seaboard Drilling Company**
Address **306 Union National Bank Building, Wichita, Kansas**

STATE OF **Kansas**, COUNTY OF **Sedgwick**, ss.

Edward M. Swearer (employee of owner) or (owner or operator) of the above-described well,
being first duly sworn on oath, says: That I have knowledge of the facts, statements, and matters herein contained and the log of the above-described well as filed and that the same are true and correct. So help me God.

(Signature) **Edward M. Swearer**
306 Union National, Wichita, Kansas
(Address)

SUBSCRIBED AND SWORN TO before me this **19th** day of **May**, 19 **45**

My commission expires **August 31, 1945**
Marianne Fisher
Notary Public.

15-169-01005-00-00

FALCON SEABOARD DRILLING COMPANY
AND
PHILLIPS PETROLEUM COMPANY

Sec. 33 T.16S R.3W
Saline County, Kansas
C W/4 SE/4 SE/4

NO. 1 MORRIS

170' of 1 1/2"
297' of 2-5/8"

Surface Sand and Shale	160
Shale & Shells	290
Anhydrite	330
Lime & Shale	530
Red Bed	555
Shale & Shells	635
Sand & Lime	675
Lime & Shale	745
Sandy Lime	815
Lime & Shale	930
Shale & Lime Shells	1505
Shale	1595
Lime (Broken)	1650
Shale & Lime	1725
Lime & Shale	2210
Lime	2445
Lime & Shale	2715
Shale	2775
Varigated Shale	2825
Shale	2890
Chat	3030
Shale	3045
Chat	3058
Shale	3080
Chat	3081
Shale	3352
Chat & Lime	3358
Viola Lime (Cored)	3345
Cherty Lime	3365
Shale & Lime	3405
Viola Lime	3475
Lime & Shale	3482
Simpson Sand	3495
Simpson Dolomite	3512
Shale	3525
Arbuckle Lime	3555

Formation Tops:

Lansing-Kansas City	2228'
Mississippian	2886'
Kinderhook	3110'
Viola	3352'
Simpson Dolomite	3444'
Simpson Shale	3467'
Simpson Sandstone	3482'
Arbuckle Dolomite	3525'

Total Depth

STATE OF KANSAS
COUNTY OF SEDGWICK

First, being duly sworn, Edward M. Swearer, hereby states that the information contained herein is a true and correct log on the above described well.

Further affiant saith not.

Edward M. Swearer

SUBSCRIBED and sworn to before me this 19th day of May, 1943

Maxine Fisher
Notary Public

My commission expires
August 31, 1946

