


15-169-00610-00-00

STATE OF KANSAS  
STATE CORPORATION COMMISSION  
CONSERVATION DIVISION  
P. O. BOX 17027  
WICHITA, KANSAS 67217

FORM CP-4

WELL PLUGGING RECORD

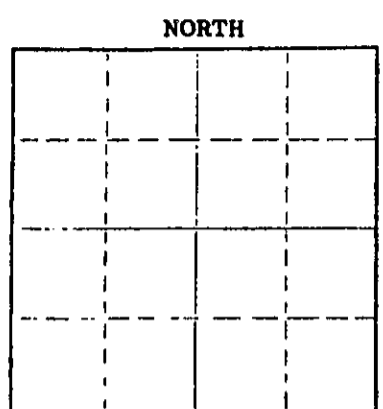

Saline County. Sec. 32 Twp. 16 Rge. 3 W (E) (W)  
Location as "NE/CNW/SE/SW" or footage from lines C S/2 NW  
Lease Owner C A P Production  
Lease Name Holm Well No. 3  
Office Address 805 West Marlin McPherson, Kansas  
Character of Well (completed as Oil, Gas or Dry Hole) oil  
Date well completed 11-11 19 59  
Application for plugging filed 7-6 19 76  
Application for plugging approved 7-7 19 76  
Plugging commenced 7-7 19 76  
Plugging completed 7-13 19 76  
Reason for abandonment of well or producing formation  
If a producing well is abandoned, date of last production 19  
Was permission obtained from the Conservation Division or its agents before plugging was commenced? Yes

Name of Conservation Agent who supervised plugging of this well Gilbert Toman  
Producing formation Depth to top Bottom Total Depth of Well 3393'  
Show depth and thickness of all water, oil and gas formations.

OIL, GAS OR WATER RECORDS CASING RECORD

FORMATION	CONTENT	FROM	TO	SIZE	PUT IN	PULLED OUT
				4 1/2"		2,213'

Describe in detail the manner in which the well was plugged, indicating where the mud fluid was placed and the method or methods used in introducing it into the hole. If cement or other plugs were used, state the character of same and depth placed, from feet to feet for each plug set.

Plugged off bottom of hole with sand. Sand from 3393 to 3350'. Dumped 4 sx of cement. Mudded hole to 360'. Made 15' of rock bridge. Dumped 3 1/2 yds of Ready-Mix cement, filling to the bottom of the celler.

(If additional description is necessary, use BACK of this sheet)  
Name of Plugging Contractor Art Lamb Casing Pulling Inc  
Address 2809 King St. Hutchinson, Kansas 67501

STATE OF Kansas COUNTY OF Reno ss.  
Art Lamb (employee of owner) or (owner or operator) of the above-described

well, being first duly sworn on oath, says: That I have knowledge of the facts, statements, and matters herein contained and the log of the above-described well as filed and that the same are true and correct. So help me God.

(Signature) [Signature] 2809 King St. Hutchinson, Kansas (Address)

Subscribed and sworn to before me this 16th day of July 19 76

My commission expires December 31, 1977 [Signature] Notary Public.

RECORDED  
JUL 19 1976  
WICHITA, KANSAS

WELL RECORD

15-169-00610-00-00

LEASE: Holm

WELL NO. 3

LOCATION: Cen. S/2 NW/4  
Section 32-16S-3W  
Saline County, Kansas

COMMENCED: 11/3/59

COMPLETED: 11/11/59  
(rotary)

OPERATOR: Warner & Stevenson  
McPherson, Kansas

RECEIVED  
STATE CORPORATION COMMISSION  
SEP 17 1971  
CONSERVATION DIVISION  
Wichita, Kansas

CONTRACTOR: Melland Drilling Company, Inc.  
1111 North Main Street  
Hutchinson, Kansas

CASING RECORD: 8-5/8" OD casing set at 360', cemented with 250 sacks.  
5-1/2" OD casing set at , cemented with 70 sacks.

FORMATION

LOG

Dirt & clay	35
Sand	75
Shale & shells	215
Gypsum, Anhydrite & lime	360
Anhydrite	400
Lime & shale	760
Shale & lime	890
Lime	1020
Shale w/ lime streaks	1145
Shale & lime	1500
Lime & shale	1550
Shale & lime	1730
Lime w/ shale	1845
Lime & shale	2635
Shale & lime	2810
Lime & shale	2912
Lime	3050
Lime w/ chert	3115
Lime	3165
Shale & lime	3210
Shale	3391

ROTARY TOTAL DEPTH

WELL LOG BUREAU—KANSAS GEOLOGICAL SOCIETY

508 East Murdock,

Wichita, Kansas


15-169-00610-00-06

Company: WARNER & STEVENSON  
 Farm: Helm No. 3

SEC. 32 T. 16 R. 3W  
 C S/2 NW

Total Depth. 3393'  
 Comm. 11-3-59 Comp. 11-11-59  
 Shot or Treated.  
 Contractor. Melland Drlg. Co.  
 Issued. 1-23-60

County Saline  
 KANSAS

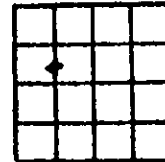

Elevation. 1360' RB

Production. 50 BOPD

CASING:

8 5/8" 360' cem w/250 sx.  
 1 1/2" 3388' cem w/70 sx.

Figures Indicate Bottom of Formations.

dirt & clay	35
sand	75
shale & shells	215
gypsum, anhydrite & lime	360
Anhydrite	400
lime & shale	760
shale & lime	890
lime	1020
shale w/lime strks	1145
shale & lime	1500
lime & shale	1550
shale & lime	1730
lime w/shale	1845
lime & shale	2635
shale & lime	2810
lime & shale	2912
lime	3050
lime w/chert	3115
lime	3165
shale & lime	3210
shale	3391 RTD
shale	3393
Total Depth	

TOPS: SCOUT	
Mississippi	2919
Kinderhook	3158
Maquoketa	3389