


15-169-00739-00-00

STATE OF KANSAS
STATE CORPORATION COMMISSION
Give All Information Completely
Make Required Affidavit
Mail or Deliver Report to:
Conservation Division
State Corporation Commission
800 Bittling Building
Wichita, Kansas

WELL PLUGGING RECORD

Saline County. Sec. 32 Twp. 16 Rge. (E) 3 (W)
Location as "NE/CNW $\frac{1}{4}$ /SW $\frac{1}{4}$ " or footage from lines NE NE NE
Lease Owner The Bay Petroleum Corporation
Lease Name Holmgren Well No. 1
Office Address Box 957 Denver Colorado
Character of Well (completed as Oil, Gas or Dry Hole) Dry Hole
Date well completed June 3 1952
Application for plugging filed July 2 1952
Application for plugging approved July 3 1952
Plugging commenced June 21 1952
Plugging completed June 25 1952
Reason for abandonment of well or producing formation Dry Hole

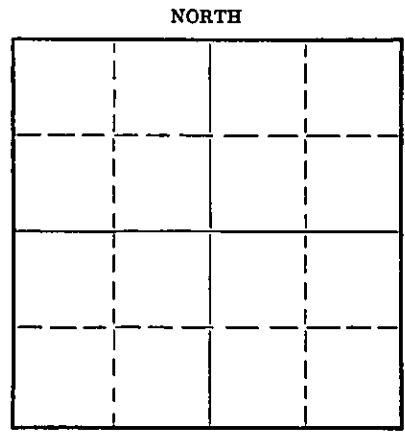

Locate well correctly on above Section Plat

If a producing well is abandoned, date of last production 19...
Was permission obtained from the Conservation Division or its agents before plugging was commenced? Yes

Name of Conservation Agent who supervised plugging of this well Mr. Durkee
Producing formation Depth to top Bottom Total Depth of Well 3381 Feet
Show depth and thickness of all water, oil and gas formations.

OIL, GAS OR WATER RECORDS

CASING RECORD

Formation	Content	From	To	Size	Put In	Pulled Out
				13 3/8"	163'	None
				8 5/8"	355'	None
				5 1/2"	3378'	2180'

Describe in detail the manner in which the well was plugged, indicating where the mud fluid was placed and the method or methods used in introducing it into the hole. If cement or other plugs were used, state the character of same and depth placed, from feet to feet for each plug set.

Ran sand from 3381' to 3370',
Ran 6 sacks cement at 3370',
Mudded hole from top of cement to 200'
Set bridge at 200',
Ran 15 sacks cement on top of bridge,
Mudded hole and ran 5 sacks cement
to base of cellar.

RECEIVED
STATE CORPORATION COMMISSION
JUL 14 1952
CONSERVATION DIVISION
Wichita, Kansas

07-19-52

(If additional description is necessary, use BACK of this sheet)
Correspondence regarding this well should be addressed to The Bay Petroleum Corporation
Address Box 513 Chase Kansas

STATE OF Kansas, COUNTY OF Rice, ss.
Glen E. Armour (employee of owner) of the above-described well,
being first duly sworn on oath, says: That I have knowledge of the facts, statements, and matters herein contained and the log of the above-described well as filed and that the same are true and correct. So help me God.

(Signature) Glen E. Armour
Lyons Kansas (Address)

SUBSCRIBED AND SWORN to before me this 18 day of July, 1952

Clarence O. Gray
Notary Public.

My commission expires May 20 1954

28-5091-s 8-50-10M

PLUGGING
FILE SEC 34 (6R-34)
BOOK PAGE 27 LINE 44

Company: Bay Petroleum Corporation
 Farm: Helmgren #1
 Comm: May 8, 1952
 Comp: May 21, 1952
 Contractor: Penguin Petroleum, Inc.

Sec. 32, T 16, R 3W
 NE NE NE
 McPherson County, Kansas
 Rotary Locals:
 Elevation: 1553'
 Rotary Total Depth: 3383'

Casing: 13 3/8" @ 184' Cem w/175 sx.
 8 5/8" @ 360.95' Cem w/225 sx.
 8 1/2" @ 3383.46' Cem w/100 sx.

0-95	Brown shale & some sand
-205	Blue shale
-263	Shale, lime & gyp rock
-523	Shale
-540	Anhydrite
-555	Shale & shells
-410	Gyp rock & shale
-490	Anhydrite
-475	Lime & shale
-520	Shale & lime
-530	red bed & shale
-550	Lime
-600	Shale
-750	Sandy shale & lime
-970	Shale & lime
-980	Red bed
-1055	Lime & shale
-1095	Shale & lime
-1125	Lime & shale
-1185	Shale & lime
-1245	Shale
-1540	Shale & lime
-1810	Shale & lime
-1910	Lime & shale
-2080	Shale & lime
-2520	Shale & lime
-2430	Lime & shale
-2510	Shale & lime
-2553	Lime & shale
-2563	Shale & lime
-2575	Lime
-2742	Shale & lime
-2830	Lime & shale
-2897	Shale
-2970	Miss. lime & chert.
-3020	lime, shale & chert.
-3099	Lime
-3137	Lime & shale
-3173	Lime
-3383	Shale

R.T.D. 3383'

Tops:	Mississippi	2897'
	Dolomite	2909'
	Maquoketa	3577'

Certified to be a true copy of the well log as indicated on daily drilling reports.

PENGUIN PETROLEUM, INC.

By Law Holland

Subscribed and sworn to before me, the undersigned, a Notary Public in and for Sedgwick County, Kansas, this 23 day of June, 1952.

My Commission Expires:

November 1, 1953

PLUGGING
 FILE SEC. 32 T. 16 R. 3W
 BOOK PAGE 22 LINE 11

Jesse English
 Notary Public