

15-101-00070-00-00

Give All Information Completely
Make Required Affidavit
Mail or Deliver Report to:
Conservation Division
State Corporation Commission
211 No. Broadway
Wichita, Kansas

WELL PLUGGING RECORD

Lane _____ County, Sec 35 Twp. 16S Rge. 28W (E) _____ (W)

Location as "NE/CNW/SW" or footage from lines c NW SW

Lease Owner G - R - O c/o W. F. Roland

Lease Name Terwilliger Well No. 1

Office Address 52 Drake, Pueblo, Colorado

Character of Well (completed as Oil, Gas or Dry Hole) Dry Hole

Date well completed February 28 19 64

Application for plugging filed February 28 19 64

Application for plugging approved February 28 19 64


Plugging commenced February 28 19 64

Plugging completed February 28 19 64

Reason for abandonment of well or producing formation Dry Hole

If a producing well is abandoned, date of last production _____ 19 _____

Was permission obtained from the Conservation Division or its agents before plugging was commenced? Yes

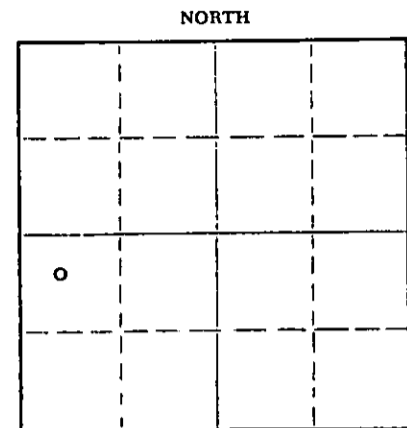

Locate well correctly on above Section Plat

Name of Conservation Agent who supervised plugging of this well W. L. Nichols, Moreland, Kansas

Producing formation _____ Depth to top _____ Bottom _____ Total Depth of Well _____ Feet

Show depth and thickness of all water, oil and gas formations.

OIL, GAS OR WATER RECORDS

CASING RECORD

FORMATION	CONTENT	FROM	TO	SIZE	PUT IN	PULLED OUT
		0	253'	8 5/8"	253'	none

Describe in detail the manner in which the well was plugged, indicating where the mud fluid was placed and the method or methods used in introducing it into the hole. If cement or other plugs were used, state the character of same and depth placed, from _____ feet to _____ feet for each plug set.

Set Plug @ 600' /20 sacks cement
240' /20 sacks cement
40' /10 sacks cement

RECEIVED
STATE CORPORATION COMMISSION

MAR 13 1964

CONSERVATION DIVISION
Wichita, Kansas

(If additional description is necessary, use BACK of this sheet)

Name of Plugging Contractor Hellar Drilling Company, Inc.

Address 1014 Union Center, Wichita, Kansas

STATE OF Kansas COUNTY OF Sedgwick, ss.

D. L. Hellar, Pres. of Hellar Drig. Co. Inc. (employee of owner) or (owner or operator) of the above-described well, being first duly sworn on oath, says: That I have knowledge of the facts, statements, and matters herein contained and the log of the above-described well as filed and that the same are true and correct. So help me God.

(Signature) D. L. Hellar D. L. Hellar, President

1014 Union Center, Wichita, Kansas

(Address)

SUBSCRIBED AND SWORN to before me this 11th day of March, 19 64

My commission expires March 25, 1964.

Catherine Darcey Notary Public.

DRILLER'S LOG

COMPANY:	G - R - O c/o W. F. Roland
CONTRACTOR:	Hellar Drilling Company, Inc.
LEASE:	#1 Terwilliger
LOCATION:	c NW SW 35-16S-28W, Lane County, Kansas
COMMENCED:	February 12, 1964
COMPLETED:	February 28, 1964
CASING:	Set 8 5/8" surface casing @ 253'/175 sacks cement

0-60	Surface Clay
60-108	Gravel
108-145	Red Bed-shale
145-233	Surface
233-253	Shale
253-1419	Shale & shells
1419-1594	Shale
1594-1625	Anhydrite
1625-2055	Shale
2055-2152	Shale & shells
2152-2189	Anhydrite
2189-2858	Shale & Lime
2858-3020	Lime & Shale
3020-3124	Lime
3124-3226	Lime & Shale
3226-3280	Lime
3280-3679	Lime & Shale
3679-3850	Shale & Lime
3850-4002	Lime & Shale
4002-4035	Lime - Lsg. K.C.
4035-4470	Lime
4470-4616	Lime & Shale 4615 Miss.
4616-4630	Sand & Lime
4630-4650	Sand
4650-4700	Sand, Shale & Lime
4700-4711	Lime & Sand
4711	Rotary Total Depth
	D & A

RECEIVED
STATE CORPORATION COMMISSION

MAR 13 1964

CONSERVATION DIVISION
Wichita, Kansas

STATE OF KANSAS)
) ss
COUNTY OF SEDGWICK)

I, D. L. Hellar, do hereby certify that the above and foregoing is a true and correct copy of the log of the #1 Terwilliger, located in c NW SW 35-16S-28W, Lane County, Kansas, as reflected by the files of the Hellar Drilling Company, Inc.

HELLAR DRILLING COMPANY, INC.

By *D. L. Hellar*
President D. L. Hellar

Subscribed and sworn to before me, a Notary Public, in and for Sedgwick County, Kansas, this 13th day of March, 1964.

My Commission Expires:
March 26, 1964

Catherine Darcey
Notary Public - Catherine Darcey