

15-053-01191-00-00

STATE OF KANSAS
STATE CORPORATION COMMISSION

WELL PLUGGING RECORD

Give All Information Completely
Make Required Affidavit
Mail or Deliver Report to:
Conservation Division
State Corporation Commission
800 Bittling Building
Wichita, Kansas

OR

Strike out upper line
when reporting plugging
of formations.

FORMATION PLUGGING RECORD

Ellsworth County. Sec. 5 Twp. 16S Rge. 10 (W)
Location as "NE 1/4 NW 1/4 SW 1/4" or footage from lines NE NW SW

Lease Owner: Sohio Petroleum Company

Lease Name: Horejsi Well No. 2

Office Address: Box 609, Russell, Kansas

Character of Well (completed as Oil, Gas or Dry Hole): Dry Hole

Date well completed: October 24, 1946

Application for plugging filed: November 12, 1946

Application for plugging approved: November 12, 1946


Plugging commenced: November 13, 1946

Plugging completed: November 14, 1946

Reason for abandonment of well or producing formation: Dry Hole

If a producing well is abandoned, date of last production: Dry Hole 19

Was permission obtained from the Conservation Division or its agents before plugging was commenced? Yes, by telephone from Mr. Herb Kerr

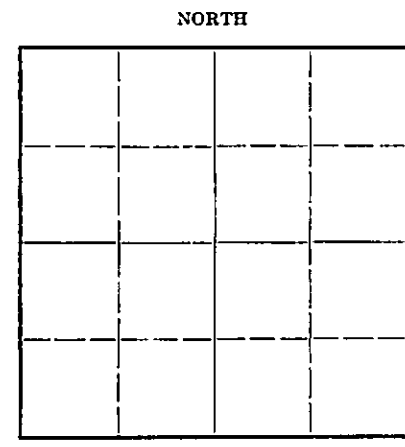

Locate well correctly on above
Section Plat

Name of Conservation Agent who supervised plugging of this well: Mr. Herb Kerr

Producing formation: None Depth to top: Bottom: Total Depth of Well: 3291 Feet

Show depth and thickness of all water, oil and gas formations.

OIL, GAS OR WATER RECORDS


CASING RECORD

Formation	Content	From	To	Size	Put In	Pulled Out
No commercial oil or gas shows from top to bottom.				8 5/8"	288'	None
				5 1/2"	3279'	1893'

Describe in detail the manner in which the well was plugged, indicating where the mud fluid was placed and the method or methods used in introducing it into the hole. If cement or other plugs were used, state the character of same and depth placed, from feet to feet for each plug set.

Sand from 3291' to 3279'
Cement 3279' to 3250' - 5 sacks
Heavy Mud 3250' to 260'
Rock bridge 260' to 250'
Cement 250' to 220' - 15 sacks
Heavy mud 220' to 25'
Cement 25' to 15' - 5 sacks
Clay 15' to 0'

5 16 10W
82 38

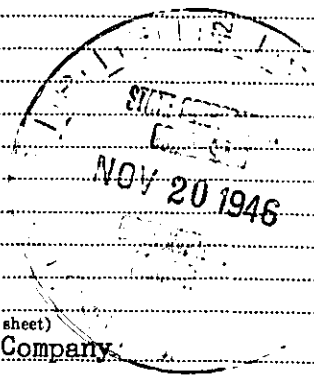

(If additional description is necessary, use BACK of this sheet)

Correspondence regarding this well should be addressed to: Sohio Petroleum Company
Address: Box 609, Russell, Kansas

STATE OF Kansas, COUNTY OF Russell, ss.
P. C. Musgrove (employee of owner) or (owner) of the above-described well,

being first duly sworn on oath, says: That I have knowledge of the facts, statements, and matters herein contained and the log of the above-described well as filed and that the same are true and correct. So help me God.

(Signature) P. C. Musgrove

(Address)

SUBSCRIBED AND SWORN to before me this 19th day of November, 1946

My commission expires May 8, 1948.

My commission expires

Bernie J. Smith
Notary Public.

C O P Y
CONTRACTOR'S VERIFIED LOG

Operator Sohio Petroleum Company Farm Name Horejsi Well No. 2

Location Sec 5 Township 16 Range 10

Pool Name _____ County Ellsworth State Kansas

Commencement Date October 2, 1946 Completion Date October 16, 1946

LOG OF WELL

Depth		Formation	Deviation from Vertical (Degrees)	Remarks
From	To			
300	600	Shale and Shells		
600	625	Anhydrate		
625	960	Shale and Shells and Red Bed		
960	1285	Shale and Shells		
1285	1868	Lime and Shale		
1868	2045	Shale and Shells		
2045	2141	Shale and Lime		
2141	2235	Shale		
2235	2360	Shale and Shells		
2360	2600	Lime and Shale		
2600	2755	Lime		
2755	2830	Lime and Shale		
2830	2870	Shale		
2870	2935	Shale, Shells and Red Bed		
2935	3040	Lime and Shale		
3040	3085	Lime		
3085	3115	Lime and Shale		
3115	3285	Lime		Total Depth

PLUGGING
FILE SEC. 5 T. 16 R. 10W
BOOK PAGE 82 INF. 38

