

15-101-19019-00-00

Form CP-4


STATE OF KANSAS  
STATE CORPORATION COMMISSION

Give All Information Completely  
Make Required Affidavit  
Mail or Deliver Report to:  
Conservation Division  
State Corporation Commission  
211 No. Broadway  
Wichita, Kansas

WELL PLUGGING RECORD

Lane \_\_\_\_\_ County, Sec. 1 Twp. 18S Rge. 27W (E) \_\_\_\_\_ (W) \_\_\_\_\_  
Location as "NE/CNW/SW" or footage from lines \_\_\_\_\_ c NE/4 NE/4

Lease Owner Hellar Drilling Company, Inc.  
Lease Name Herl Well No. 1  
Office Address 1014 Union Center, Wichita 2, Kansas  
Character of Well (completed as Oil, Gas or Dry Hole) Dry Hole  
Date well completed December 17 19 62  
Application for plugging filed December 17 19 62  
Application for plugging approved December 17 19 62  
Plugging commenced December 17 19 62  
Plugging completed December 17 19 62  
Reason for abandonment of well or producing formation Dry Hole

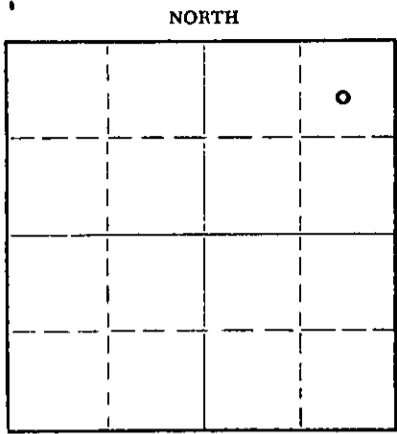

Locate well correctly on above  
Section Plat

If a producing well is abandoned, date of last production \_\_\_\_\_ 19 \_\_\_\_\_  
Was permission obtained from the Conservation Division or its agents before plugging was commenced? Yes

Name of Conservation Agent who supervised plugging of this well Eldon Petty, Box 326, Hays, Kansas  
Producing formation \_\_\_\_\_ Depth to top \_\_\_\_\_ Bottom \_\_\_\_\_ Total Depth of Well \_\_\_\_\_ Feet  
Show depth and thickness of all water, oil and gas formations.

OIL, GAS OR WATER RECORDS

CASING RECORD

FORMATION	CONTENT	FROM	TO	SIZE	PUT IN	PULLED OUT
		0	290'	8 5/8"	290'	None

Describe in detail the manner in which the well was plugged, indicating where the mud fluid was placed and the method or methods used in introducing it into the hole. If cement or other plugs were used, state the character of same and depth placed, from \_\_\_\_\_ feet to \_\_\_\_\_ feet for each plug set.

Set Plug @ 600' w/ 20 sacks cement  
Plug @ 240' w/ 20 sacks cement  
Plug @ 40' w/ 10 sacks cement

RECEIVED  
STATE CORPORATION COMMISSION

DEC 28 1962  
12-28-1962

CONSERVATION DIVISION  
Wichita, Kansas

(If additional description is necessary, use BACK of this sheet)

Name of Plugging Contractor Hellar Drilling Company, Inc.  
Address 1014 Union Center, Wichita 2, Kansas

STATE OF Kansas, COUNTY OF Sedgwick, ss.

D. L. Hellar, Pres. of Hellar Drilling Co., Inc. (employee of owner) or (owner or operator) of the above-described well, being first duly sworn on oath, says: That I have knowledge of the facts, statements, and matters herein contained and the log of the above-described well as filed and that the same are true and correct. So help me God.

(Signature) D. L. Hellar D. L. Hellar, Pres.  
1014 Union Center, Wichita 2, Kansas  
(Address)

SUBSCRIBED AND SWORN to before me this 26th day of December, 19 62

My commission expires March 25, 1964.

Catherine Darcey  
Catherine Darcey -- Notary Public.



15-101-19019-0000

DRILLER'S LOG

OWNER: Hellar Drilling Company, Inc.  
 CONTRACTOR: Hellar Drilling Company, Inc.  
 LEASE: #1 Herl  
 LOCATION: c NE NE 1-18S-27W  
 Lane County, Kansas  
 COMMENCED: December 5, 1962  
 COMPLETED: December 17, 1962  
 CASING: Set 8 5/8" surface casing @ 290'/215 Sacks cement

0- 290	Sand, Red Bed, Shale
290- 425	Shale & Shells
425-1396	Shale & Red Bed
1396-1403	Blaine
1403-1413	Blaine-Anhydrite
1413-1888	Shale, Red Bed, Sand
1888-1960	Red Bed
1960-1997	Cinn.-Anhydrite
1997-2356	Shale-Red Bed
2356-2554	Shale-Lime
2554-2705	Salt Section
2705-2850	Shale-Lime
2850-3232	Lime-Shale
3232-3476	Shale-Lime
3476-3709	Lime-Shale
3709-3812	Lime with Shale Stks.
3812-3880	Lime-Shale
3880-3973	Lime
3973-4029	Lsg., K.C.
4029-4151	Lime
4151-4200	Lsg., K.C.
4200-4324	Lime-Shale
4324-4335	Marmathon Section
4335-4528	Lime & Shale
4528-4543	Mississippi
4543-4570	Lime & Shale
4570	Rotary Total Depth
	D & A

RECEIVED  
 STATE CORPORATION COMMISSION  
 DEC 28 1962  
 12-28-1962  
 CONSERVATION DIVISION  
 Wichita, Kansas

STATE OF KANSAS )  
 ) ss  
 COUNTY OF SEDGWICK )

*Fidelity Cement Shale*

I, D. L. Hellar, do hereby certify that the above and foregoing is a true and correct copy of the log of the #1 Herl, located in c NE NE Section 1-18S-27W, Lane County, Kansas, as reflected by the files of the Hellar Drilling Company, Inc.

HELLAR DRILLING COMPANY, INC.

By *D. L. Hellar*  
 D. L. Hellar, President

Subscribed and sworn to before me, a Notary Public, in and for Sedgwick County, Kansas, this 26th day of December, 1962.

My Commission Expires:  
 March 25, 1964.

*Catherine Darcey*  
 Notary Public - Catherine Darcey