


15-101-20229-00-00

STATE OF KANSAS
STATE CORPORATION COMMISSION

WELL PLUGGING RECORD

Give All Information Completely
Make Required Affidavit
Mail or Deliver Report to
Conservation Division
State Corporation Comm.
245 North Water
Wichita, KS 67202

Lane _____ County. Sec. 22 Twp. 17S Rge. 27 W
Location as "NE/CNW 1/4 SW 1/4" or footage from lines _____
SE NE SW 1650' FSL & 2310' FWL
Lease Owner Bass Enterprises Production Co.
Lease Name Glen C. Wheatcroft Well No. 1
Office Address Box 2760, Midland, Texas 79702
Character of Well (Completed as Oil, Gas or Dry Hole) _____

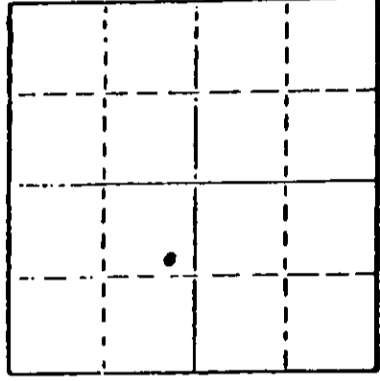

Locate well correctly on above
Section Plot

Dry hole.
Date Well completed June 21, 1977 19
Application for plugging filed June 21, 1977 19
Application for plugging approved June 21, 1977 19
Plugging commenced June 21, 1977 19
Plugging completed June 21, 1977 19
Reason for abandonment of well or producing formation _____
Dry hole.

If a producing well is abandoned, date of last production _____ 19

Was permission obtained from the Conservation Division or its agents before plugging was commenced? Yes

Name of Conservation Agent who supervised plugging of this well Gilbert Balthazor
Producing formation _____ Depth to top -- Bottom -- Total Depth of Well 4401'
Show depth and thickness of all water, oil and gas formations.

OIL, GAS OR WATER RECORDS

CASING RECORD

FORMATION	CONTENT	FROM	TO	SIZE	PUT IN	PULLED OUT
				8 5/8"	253'	None

Describe in detail the manner in which the well was plugged, indicating where the mud fluid was placed and the method or methods used in introducing it into the hold. If cement or other plugs were used, state the character of same and depth placed, from _____ feet to _____ feet for each plug set.

- Plug No. 1 - 70 sks 50-50 Poz-mix w/6% Gel @ 850'
- Plug No. 2 - 20 sks 50-50 Poz-mix w/6% Gel @ 250'
- Plug No. 3 - Rubber plug @ 40' topped with 10 sks 50-50 Poz-mix w/6% Gel

6-29-77

(If additional description is necessary, use BACK of this sheet)

Name of Plugging Contractor Rains & Williamson Oil Co., Inc.

STATE OF TEXAS COUNTY OF MIDLAND, ss.
H. F. Wurtz, Jr., employee of owner (employee of owner) or (owner or operator of the above-described well, being first duly sworn on oath, says: That I have knowledge of the facts, statements, and matters herein contained and the log of the above-described well as filed and that the same are true and correct. So help me God.

(Signature) H. F. Wurtz, Jr.
Box 2760, Midland, Texas
(Address)

SUBSCRIBED AND SWORN TO before me this 27th day of June, 1977.

B. R. Scown
B. R. Scown, Notary Public.
Midland County, Texas

My commission expires June 1, 1979

15-101-20229-00-00

DRILLER'S LOG

COMPANY: Bass Enterprises Production Co.

SEC. 22 T. 17S R. 27W

WELL NAME: Wheatcroft #1

LOC. SE NE SW

COUNTY: Lane

RIG NO. #1

TOTAL DEPTH 4401'

ELEVATION

COMMENCED: 6-13-77

COMPLETED: 6-21-77

CONTRACTOR: Rains & Williamson Oil Co., Inc.

CASING RECORD:

SURFACE: 8 5/8" @ 253' w/180 sx. 50/50 poz., 3% cc., 2% gel.

PRODUCTION: D&A

LOG

(Figures Indicate Bottom of Formations)

Shale	360
Sand, Clay & Shale	1380
Shale & Sand	2245
Sand & Shale	2688
Shale, Sand & Lime	2956
Lime	3127
Shale & Lime	4020
Lime & Shale	4200
Shale & Lime	4275
Lime	4401
<u>ROTARY TOTAL DEPTH</u>	<u>4401</u>

STATE OF Kansas)


COUNTY OF Sedgwick)

SS:

I, Wilson Rains, President of Rains & Williamson Oil Co., Inc.

upon oath state that the above and foregoing is a true and correct copy of the log of the Wheatcroft #1 well.

Wilson Rains
Wilson Rains

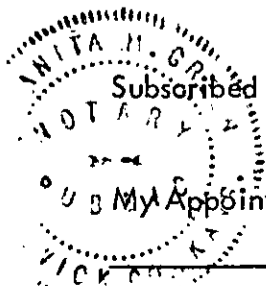

Subscribed and sworn to before me this 22 day of June, 19 77.

My Appointment Expires: 10-4-79

Juanita M. Green
Juanita M. Green