

15-101-20135-00-00

STATE OF KANSAS
STATE CORPORATION COMMISSION

Form CP-4

Give All Information Completely
Make Required Affidavit
Mail or Deliver Report to:
Conservation Division
State Corporation Commission
211 No. Broadway
Wichita, Kansas

WELL PLUGGING RECORD

LANE _____ County. Sec. 18 Twp. 17S Rge. (E) 27 (W)

Location as "NE/CNW/SW" or footage from lines. C-SW-NW-SE

Lease Owner MALLONEE-MAHONEY, INC.

Lease Name D. WATERSON

Well No. 1

Office Address BOX 1257, LIBERAL, KANSAS 67901

Character of Well (completed as Oil, Gas or Dry Hole) DRY HOLE

Date well completed 1/8/ 19 75

Application for plugging filed 1/9/ 19 75

Application for plugging approved BY PHONE 1/9/ 19 75


Plugging commenced 1/9/ 19 75

Plugging completed 1/9/ 19 75

Reason for abandonment of well or producing formation _____

If a producing well is abandoned, date of last production _____ 19 _____

Was permission obtained from the Conservation Division or its agents before plugging was commenced? YES

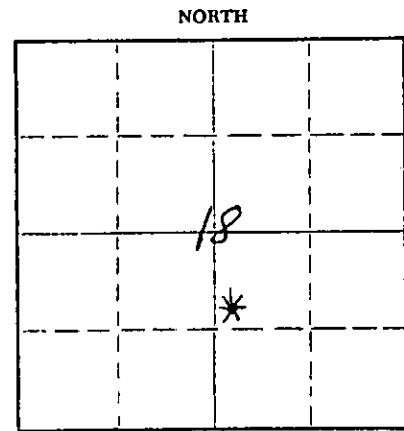

Locate well correctly on above Section Plat

Name of Conservation Agent who supervised plugging of this well DALE BALTHAZOR

Producing formation _____ Depth to top _____ Bottom _____ Total Depth of Well 4610' Feet

Show depth and thickness of all water, oil and gas formations.

OIL, GAS OR WATER RECORDS

CASING RECORD

FORMATION	CONTENT	FROM	TO	SIZE	PUT IN	PULLED OUT

Describe in detail the manner in which the well was plugged, indicating where the mud fluid was placed and the method or methods used in introducing it into the hole. If cement or other plugs were used, state the character of same and depth placed, from _____ feet to _____ feet for each plug set.

CEMENT PLUG @ 1,000' w/70 SX 50-50 POZ MIX, 6% GEL.

CEMENT PLUG @ 380' w/20 SX 50-50 POZ MIX, 6% GEL.

WOOD AND CEMENT PLUG @ 40' w/10 SX

PLUG RAT HOLE w/2 SX

RECEIVED
STATE CORPORATION COMMISSION

RECEIVED
STATE CORPORATION COMMISSION

JAN 21 1975

CONSERVATION DIVISION
Wichita, Kansas

JAN 15 1975

CONSERVATION DIVISION
Wichita, Kansas

(If additional description is necessary, use BACK of this sheet)

Name of Plugging Contractor SLAWSON DRILLING CO.,

Address WICHITA, KANSAS

STATE OF KANSAS, COUNTY OF SEWARD, ss.

B. A. CLIFFT

(employee of owner) or (owner or operator) of the above-described

well, being first duly sworn on oath, says: That I have knowledge of the facts, statements, and matters herein contained and the log of the above-described well as filed and that the same are true and correct. So help me God

(Signature)

Box 1257, LIBERAL, KS. 67901
(Address)

Sworn to before me this 13TH day of JANUARY, 19 75

PATRICIA A. PENNINGTON

Notary Public.



15-101-20135-00-00

DRILLERS LOG

RECEIVED
STATE CORPORATION COMMISSION

JAN 21 1975

CONSERVATION DIVISION
Wichita, Kansas

COMPANY: MALLONEE-MAHONEY, INC.
925 SUTTON PLACE
WICHITA, KANSAS 67202

LEASE: D. WATERSON No.1
SW NW SE - SEC. 18-17S-27W
LANE COUNTY, KANSAS

CONTRACTOR: SLAWSON DRILLING COMPANY, INC.
408 One Twenty Building
Wichita, Kansas 67202

TOTAL DEPTH: 4610'

COMMENCED: 12-31-74


COMPLETED: 1-9-75

CASING: 364.21' of 8-5/8" set at 371' with 250 sacks cement

0' to 134' Clay, Sand & Shale
134' to 382' Sand & Shale
382' to 2109' Shale and Shells
2109' to 2148' Anhydrite
2148' to 2480' Shale and Shells
2480' to 2758' Shale & Lime
2758' to 4140' Lime and Shale
4140' to 4610' Lime
4610' RTD

STATE OF KANSAS
COUNTY OF SEDGWICK

I, JAMES C. REMSBERG, of the SLAWSON DRILLING COMPANY, INC.
upon oath state that the above and foregoing is a true and correct copy
of the log of the D.WATERSON NO.1.


James C. Remsberg



Subscribed and sworn to me on January 14, 1975.


Mary Lou Taylor

My commission expires January 17, 1977