

15-101-20130-00-00

Give All Information Completely
Make Required Affidavit
Mail or Deliver Report to:
Conservation Division
State Corporation Commission
211 No. Broadway
Wichita, Kansas

WELL PLUGGING RECORD

LANE County. Sec. 18 Twp. 17S Rge. (E) 27 (W)

Location as "NE/CNW/SW" or footage from lines 990' EWL, 330' SNL NE NW NW

Lease Owner MALLONEE-MAHONEY, INC.

Lease Name WATERSON Well No. 1

Office Address BOX 1257, LIBERAL, KANSAS 67901

Character of Well (completed as Oil, Gas or Dry Hole) DRY HOLE

Date well completed 11/9/ 19 74

Application for plugging filed BY PHONE 11/10/ 19 74

Application for plugging approved BY PHONE 11/10/ 19 74


Plugging commenced 11/10/ 19 74

Plugging completed 11/10/ 19 74

Reason for abandonment of well or producing formation

If a producing well is abandoned, date of last production 19

Was permission obtained from the Conservation Division or its agents before plugging was commenced? YES

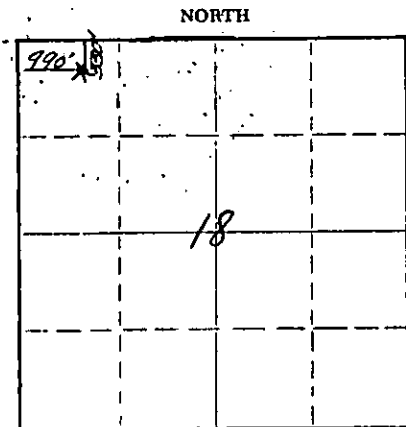

Locate well correctly on above Section Plat

Name of Conservation Agent who supervised plugging of this well CLARENCE THOMAS, GARDEN CITY, KS.

Producing formation Depth to top Bottom Total Depth of Well 4645' Feet

Show depth and thickness of all water, oil and gas formations.

OIL, GAS OR WATER RECORDS

CASING RECORD

FORMATION	CONTENT	FROM	TO	SIZE	PUT IN	PULLED OUT

Describe in detail the manner in which the well was plugged, indicating where the mud fluid was placed and the method or methods used in introducing it into the hole. If cement or other plugs were used, state the character of same and depth placed, from feet to feet for each plug set.

- 70' SX COMMON @ 1,000'
- 20 SX COMMON @ 340'
- 10 SX COMMON @ 40'

RECEIVED
STATE CORPORATION COMMISSION
NOV 13 1974
CONSERVATION DIVISION
Wichita, Kansas

(If additional description is necessary, use BACK of this sheet)

Name of Plugging Contractor GABBERT-JONES, INC.

Address WICHITA, KANSAS

STATE OF KANSAS COUNTY OF SEWARD, ss.

B. A. CLIFFT (employee of owner) or (owner or operator) of the above-described

well, being first duly sworn on oath, says: That I have knowledge of the facts, statements, and matters herein contained and the log of the above-described well as filed and that the same are true and correct. So help me God.

(Signature) Bill Clift


BOX 1257, LIBERAL, KANSAS 67901

(Address)

12TH day of NOVEMBER, 1974

Patricia A. Pennington
PATRICIA A. PENNINGTON Notary Public.

My commission expires 12/14/75

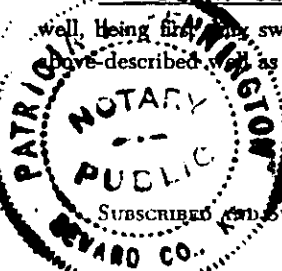

15-101-20130-00-00

GABBERT-JONES, INC.
WICHITA, KANSAS
DRILLERS' WELL LOG

RECEIVED
STATE CORPORATION COMMISSION
NOV 20 1974
CONSERVATION DIVISION
Wichita, Kansas

Waterson #1
NE-NW-NW Sec 18-17S-27W
Lane County Kansas

Commenced: 10-25-74

Completed: 11-10-74

OPERATOR: MALLONEE-MAHONEY

Depth From	to	Formation	Remarks
0	446	Surface Clay-Shale	
446	2137	Shale	Ran 8 jts of 8 5/8" csg set @ 442' Cemented w/250 ska
2137	2174	Anhy	Common 2% Gell 3% CC
2174	2500	Shale-Redbed	PD @ 12:01 a.m. 10-26-74
2500	2641	Redbed	
2641	3028	Shale-Lime	
3028	3143	Lime-Shale	
3143	3295	Shale-Lime	
3295	3407	Lime-Shale	
3407	3686	Shale-Lime	
3686	3840	Lime-Shale Stks	
3840	4125	Lime-Shale	
4125	4250	Lime	
4250	4279	Lime-Shale	
4279	4301	Lime	
4301	4327	Lime-Shale	
4327	4645	Lime	
	4645		DRY & ABANDONED

I, James S. Sutton III certify this is a correct copy of the Drillers' Log for the well drilled NE-NW-NW Sec 18-17S-27W Lane County Kansas to the best of my knowledge and belief.

James S. Sutton II
JAMES S. SUTTON II

STATE OF KANSAS)
) SS
COUNTY OF SEDGWICK)

Before me, the undersigned, a Notary Public within and for said County and State, on this 13th day of November, 1974, personally appeared James S. Sutton II to me personally known to be the identical person who executed the within and foregoing instrument and acknowledged to me that he executed the same as his free and voluntary act and deed for the uses and purposes therein set forth.

IN WITNESS WHEREOF, I have hereunto set my hand and official seal the day and year last above written.

Marjorie Hall
MARJORIE HALL-NOTARY PUBLIC



My Commission Expires: November 29th, 1973.