

15-101-20837-00-00


STATE OF KANSAS  
STATE CORPORATION COMMISSION  
200 Colorado Derby Bldg.  
Wichita, Kansas 67202

Form CP-4  
Rev. 12-15-80

WELL PLUGGING RECORD

Give All Information Completely  
Make Required Affidavit

COUNTY            Lane            SEC. 29 TWP. 17S RGE. 27 E/W  
Location as in quarters or footage from lines:  
           SW NW NW           

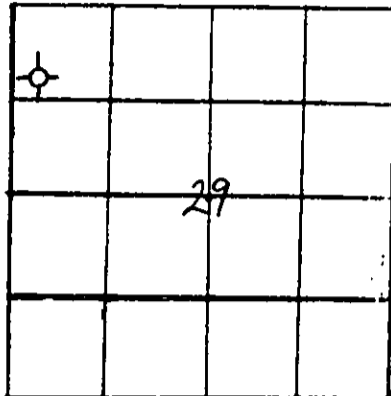

Locate Well  
correctly on above  
Section Platt.

Lease Owner            Gear Petroleum Co., Inc.  
Lease Name            Leo            Well No. #1-29  
Office Address 300 Sutton Place, Wichita, Ks. 67202  
Character of Well (Completed as Oil, Gas or Dry Hole): D.H.(C)(L)  
Date Well Completed 8-28-83  
Application for plugging filed 8-28-83  
Plugging commenced 8-28-83  
Plugging completed 8-28-83  
Reason for abandonment of well or producing formation           

Was permission obtained from the Conservation Division or it's  
Agent's before plugging was commenced? yes

Name of Conservation Agent who supervised plugging of this well Steve Durrant

Producing formation            Depth to top            bottom            T.D. 4670'

Show depth and thickness of all water, oil and gas formations.

OIL, GAS OR WATER RECORDS

Casing Record

Formation	Content	From	To	Size	Put in	Pulled Out
Surface	323' new 20#	8 5/8"	set @ 332'	cem. w/200 sx.	common	
					3% c.c.	2% gel

Describe in detail the manner in which the well was plugged, indicating where the mud fluid was placed and the method or methods used in introducing it into the hold. If cement or other plugs were used, state the character of same and depth placed, from            feet to            feet for each plug set.

Plugged @ T.D. 4670' w/50 sx., @ 2100',  
50 sx., @ 960', 40 sx., @ 360', 10 sx.  
@ 40', w/a sack of hulls & plug, circulated  
10 sx. in the rat hole, 10 sx. in the mouse hole,  
60-40 pos mix, 2% gel, 3% c.c., 170 sx. total,  
started @ 7:00 a.m., completed @ 11:15 a.m.  
Steve Durrant State Plugger

(If additional description is necessary, use BACK of this sheet)

Name of Plugging Contractor Warrior Drilling Company, Rig #2


STATE OF Kansas COUNTY OF Sedgwick, ss.  
F.W. Shelton, Jr., (employee of owner) ~~xxx (owner or operator)~~

of the above-described well, being first duly sworn on oath, says: That I have knowledge of the facts, statements, and matters herein contained and the log of the above-described well as filed and that the same are true and correct. So help me God.

CONSERVATION DIVISION  
Wichita, Kansas

(Signature) F.W. Shelton, Jr.  
F.W. Shelton, Jr., Vice Pres.  
(Address)

SUBSCRIBED AND SWORN TO before me this 28th day of August, 19 83

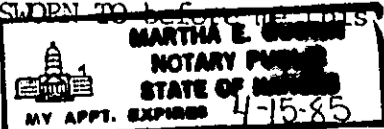

Martha E. Gustin  
Martha E. Gustin Notary Public.

My Commission expires: