

STATE OF KANSAS
STATE CORPORATION COMMISSION
CONSERVATION DIVISION
200 Colorado Derby Building
Wichita, Kansas 67202

FORM CP-1
Rev. 03/92
RECEIVED
KANSAS CORPORATION COMMISSION
WICHITA, KS

JAN 31 1995

WELL PLUGGING APPLICATION FORM
(PLEASE TYPE FORM and File ONE Copy)

API # 15-101-21,692-00-00 (Identifier number of this well). This well is listed for wells drilled since 1967; if no API# was issued, indicate spud or completion date.

WELL OPERATOR Pickrell Drilling Company, Inc. KCC LICENSE # 5123
(owner/company name) (operator's)

ADDRESS 110 N. Market, Suite 205 CITY Wichita

STATE KS ZIP CODE 67202 CONTACT PHONE # (316) 262-8427

LEASE Johnson "JJ" WELL# 1 SEC. 8 T. 17S R. 27 (Base/West)

-NW -NE -NW SPOT LOCATION/QQQQ COUNTY Lane

4950 FEET (in exact footage) FROM (S)N (circle one) LINE OF SECTION (NOT Lease Line)

3630 FEET (in exact footage) FROM (E)W (circle one) LINE OF SECTION (NOT Lease Line)

Check One: OIL WELL GAS WELL D&A SWD/ENHR WELL DOCKET# _____

CONDUCTOR CASING SIZE _____ SET AT _____ CEMENTED WITH _____ SACKS

SURFACE CASING SIZE 8 5/8 SET AT 261 CEMENTED WITH 170 SACKS

PRODUCTION CASING SIZE 4 1/2 SET AT 4646 CEMENTED WITH 210 SACKS

LIST (ALL) PERFORATIONS and BRIDGEPLUG SETS: Perfs. 4582-4586 B.P. 4505 Perfs. 4411-4413

ELEVATION 2710 KB T.D. 4651 PBD 4505 ANHYDRITE DEPTH 2122
(G.L./K.B.) (Stone Corral Formation)

CONDITION OF WELL: GOOD POOR CASING LEAK JUNK IN HOLE

PROPOSED METHOD OF PLUGGING Plug back w/ sand to 4350. Use dump bailer to spot 5 sx. of cement on sand. Cut and recover casing. Plug top hole as directed by K.C.C. representative
(Telephone 316-225-6760).

(If additional space is needed attach separate page)

IS WELL LOG ATTACHED TO THIS APPLICATION AS REQUIRED? Yes IS ACO-1 FILED? Yes

If not explain why? _____

PLUGGING OF THIS WELL WILL BE DONE IN ACCORDANCE WITH K.S.A. 55-101 et. seq. AND THE RULES AND REGULATIONS OF THE STATE CORPORATION COMMISSION.

LIST NAME OF COMPANY REPRESENTATIVE AUTHORIZED TO BE IN CHARGE OF PLUGGING OPERATIONS:

Ed Mondero PHONE# (913) 798-2430

ADDRESS Box 375 City/State Ness City, KS 67560

PLUGGING CONTRACTOR Mikes Testing & Salvage, Inc. KCC LICENSE # 31529
(company name) (contractor's)

ADDRESS Box 209, Chase, KS 67524-0209 PHONE # (816) 938-2943


PROPOSED DATE AND HOUR OF PLUGGING (If Known?) January 31, 1995

PAYMENT OF THE PLUGGING FEE (K.A.R. 82-3-118) WILL BE GUARANTEED BY OPERATOR OR AGENT

DATE: 1-30-95 AUTHORIZED OPERATOR/AGENT: Jack Gurley
(signature)

New Completion Workover

Oil Company _____ Well No. 1 Field _____ Lease Johnson JJ
Company Man _____ Date Drilled 1/95 County Wauke State Kansas
15-101-21,692-00-00

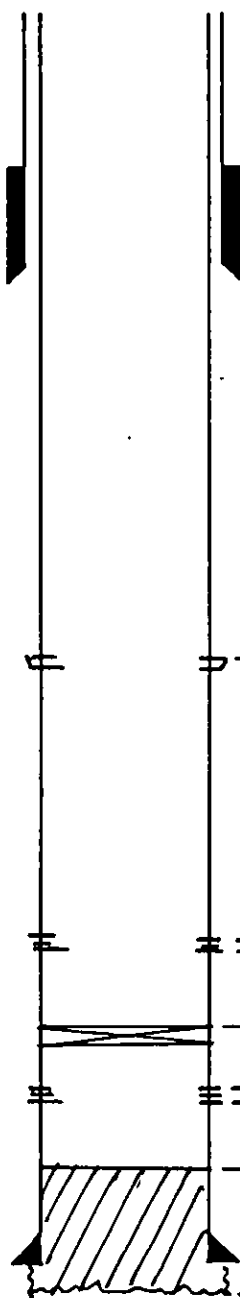

- 261' Base 8 7/8" w/170 Sx

- 2111 Port Collar (Not Cemented)

- 4411-4413 (Pawnee Perfs)

- 4505 CIBP

- 4582-4586 (Chero. Perfs)

- 4614 Original PBTD (Loggers)

- 4646 Base 4 1/2" 10.5# Csg w/110 Sx 60/40 plus 1005x Common.
- 4651 RTD

RECEIVED
KANSAS CORPORATION COMMISSION

JAN 31 1995

CONSERVATION DIVISION
WICHITA, KS

REMARKS: _____



Kansas Corporation Commission

Bill Graves, Governor Susan M. Seltsam, Chair F.S. Jack Alexander, Commissioner Rachel C. Lipman, Commissioner
Judith McConnell, Executive Director Brian Moline, General Counsel

NOTICE OF RECEIPT OF WELL PLUGGING APPLICATION (CP-1)

January 31, 1995

Pickrell Drilling Company Inc
110 N Market Suite 205
Wichita KS 67202

Johnson "JJ" #1
API 15-101-21,692 -00-00
4950 FSL 3630 FEL
Sec. 08-17S-27W
Lane County

Dear Ed Mondero,

This letter is to notify you that the Conservation Division is in receipt of your plugging proposal, form CP-1, for the above-captioned well.

Your CP-1 has been reviewed by the Conservation Division central office for completeness and to verify license numbers. The plugging proposal will now be forwarded to the district office listed below for review of your proposed method of plugging.

Please contact the district office for approval of your proposed plugging method at least at five (5) days before plugging the well, pursuant to K.A.R. 82-3-113 (b). If a workover pit will be used during the plugging of the well it must be permitted. A CDP-1 form must be filed and approved prior to the use of the pit.

The Conservation Division's review of form CP-1, either in the central or district office, does not include an inquiry into well ownership or the filing operator's legal right to plug the well.

This notice in no way constitutes authorization to plug the above-captioned well by persons not having legal rights of ownership or interest in the well. This notice is void after ninety (90) days from the above date.

Sincerely,

David P. Williams
Production Supervisor

District: #1
304 W. McArtor
Dodge City KS 67801
(316) 225-6760