

STATE OF KANSAS  
 STATE CORPORATION COMMISSION  
 200 Colorado Derby Bldg.  
 Wichita, Kansas 67202


Form CP-4  
 Rev. 12-15-80

WELL PLUGGING RECORD

15-101-20806-00-00

Give All Information Completely  
 Make Required Affidavit

COUNTY Lane SEC. 31 TWP. 16S RGE. 29 NE/W  
 Location as in quarters or footage from lines:  
 NW NE NE

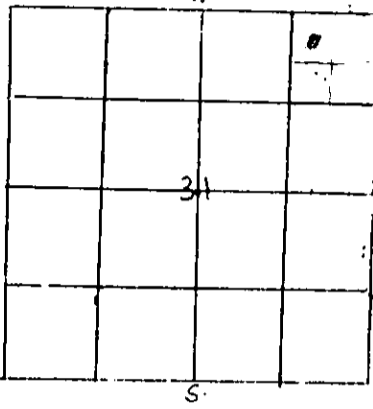

Locate Well  
 correctly on above  
 Section Platt.

Lease Owner Blue Goose Drilling Co., Inc.  
 Lease Name Dickey Well No. 1  
 Office Address P.O. Box 1413 Great Bend, KS 67530  
 Character of Well (Completed as Oil, Gas or Dry Hole): Dry Hole  
 Date Well Completed 6-18-83  
 Application for plugging filed 6-18-83  
 Plugging commenced 6-18-83  
 Plugging completed 6-18-83  
 Reason for abandonment of well or producing formation \_\_\_\_\_

DRY HOLE

Was permission obtained from the Conservation Division or it's  
 Agent's before plugging was commenced? YES

Name of Conservation Agent who supervised plugging of this well Steve Durrant  
 Producing formation \_\_\_\_\_ Depth to top \_\_\_\_\_ bottom \_\_\_\_\_ T.D. 4600'

Show depth and thickness of all water, oil and gas formations.

OIL, GAS OR WATER RECORDS

Casing Record

Formation	Content	From	To	Size	Put in	Pulled Out
Surface		0	253'	8 5/8	250'	0

Describe in detail the manner in which the well was plugged, indicating where the mud  
 fluid was placed and the method or methods used in introducing it into the hold. If cement  
 or other plugs were used, state the character of same and depth placed, from \_\_\_\_\_ feet  
 to \_\_\_\_\_ feet for each plug set.

4600' T.D. 160 Sacks 60-40 Posmix 2% Gel 3% cc  
 1st Plug at 2220' with 50 Sacks  
 2nd Plug at 1020' with 50 Sacks  
 3rd Plug at 270' with 40 Sacks  
 Top Plug Solid Bridge at 40' with 10 Sacks  
 Circulated thru it, drill pipe in Rathold 10 Sacks  
 Plug down at 2:45 A.M. 6-18-83 Sun Cementing

(If additional description is necessary, use BACK of this sheet)

Name of Plugging Contractor Blue Goose Drilling Co., Inc.

STATE OF KANSAS COUNTY OF BARTON, ss.

George E. Miller, Jr. (employee of owner) or (owner or operator) of the  
 above-described well, being first duly sworn on oath, says: That I have knowledge of the  
 facts, statements, and matters herein contained and the log of the above-described well as  
 filed and that the same are true and correct. So help me God.

(Signature) George E. Miller, Jr.  
P.O. Box 1413 Great Bend, KS 67530  
 (Address)

SUBSCRIBED AND SWORN TO before me this 20th day of June, 19 83

Helen C. Standley RECEIVED  
 Notary Public  
 STATE CORPORATION COMMISSION

My Commission expires: 12-8-83

JUN 27 1983  
 06-27-1983  
 CONSERVATION DIVISION  
 Wichita, Kansas