

15-101-20251-00-00


STATE OF KANSAS
STATE CORPORATION COMMISSION

WELL PLUGGING RECORD

Give All Information Completely
Make Required Affidavit
Mail or Deliver Report to
Conservation Division
State Corporation Comm.
245 North Water
Wichita, KS 67202

Lane _____ County. Sec. 25 Twp. 16 Rge. 29 E/W
Location as "NE/CNW/SW" or footage from lines _____
SE NW NW

Lease Owner Petroleum, Inc.
Lease Name Eaton 'P' Well No. 1
Office Address Box 1447, Great Bend, Kansas 67530
Character of Well (Completed as Oil, Gas or Dry Hole) _____
Dry Hole

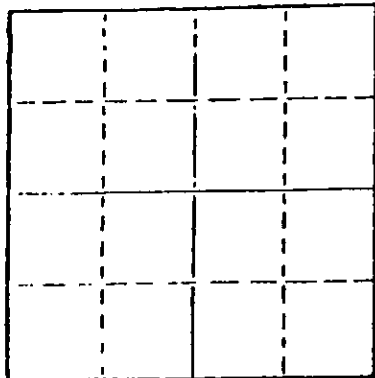

Locate well correctly on above
Section Plot

Date Well completed 9/30/77 19
Application for plugging filed 9/30/77 19
Application for plugging approved 9/30/77 19
Plugging commenced 9/30/77 19
Plugging completed 9/30/77 19
Reason for abandonment of well or producing formation _____

If a producing well is abandoned, date of last production _____ 19

Was permission obtained from the Conservation Division or
its agents before plugging was commenced? Yes

Name of Conservation Agent who supervised plugging of this well Gilbert Balthazor
Producing formation _____ Depth to top _____ Bottom _____ Total Depth of Well 4600
Show depth and thickness of all water, oil and gas formations.

OIL, GAS OR WATER RECORDS

CASING RECORD

FORMATION	CONTENT	FROM	TO	SIZE	PUT IN	PULLED OUT
	Surface	0	283	8-5/8	yes	no

Describe in detail the manner in which the well was plugged, indicating where the mud fluid was placed and the method or methods used in introducing it into the hold. If cement or other plugs were used, state the character of same and depth placed, from _____ feet to _____ feet for each plug set.

Bottom plug at 900' with 70 sacks 50/50 poz 6% gel
Middle plug at 240' with 20 sacks 50/50 poz 6% gel
Top and bridge at 40' with 10 sacks 50/50 poz, 6% gel
2 sacks in rathole
Job complete at 10:45 a.m. 9/30/77

(If additional description is necessary, use BACK of this sheet)

Name of Plugging Contractor Slawson Drilling Company, Inc.

STATE OF Kansas COUNTY OF Sedgwick, ss.
James C. Remsberg (employee of owner) or (owner or operator)
of the above-described well, being first duly sworn on oath, says: That I have knowledge of the facts, statements, and matters herein contained and the log of the above-described well as filed and that the same are true and correct. So help me God.

(Signature) James C. Remsberg
James C. Remsberg
200 Douglas Building, Wichita, Kansas 67202
(Address)

SUBSCRIBED AND SWORN TO before me this 8 day of October, 1977

Mary Lou Taylor
Mary Lou Taylor Notary Public.

My commission expires January 17, 1981

Rec'vd
10-11-1977



DRILLERS LOG

OPERATOR: Petroleum, Inc.
P. O. Box 1447
Great Bend, Kansas 67530

CONTRACTOR: Slawson Drilling Company, Inc.
200 Douglas Building
Wichita, Kansas 67202

Lease: Eaton 'P' No. 1
SE NW NW Sec. 25-16S-29W
Lane County, Kansas

COMMENCED: 9/21/77

COMPLETED: 9/30/77

RTD: 4600'

CASING: 8-5/8 at 283 with 200 sx cement

0' to 287' Clay, Sand & Shale (12½" Surface Hole)
287' to 500' Sand & Shale
500' to 1770' Shale & Shells with sand strks. (Sand At 1736)
1770' to 2118' Sand & Shale
2118' to 2192' Shale
2192' to 2222' Anhydrite
2222' to 2832' Shale & Shells
2832' to 3046' Shale & Lime
3046' to 3975' Lime & Shale
3975' to 4600' Lime
4600' RTD

10-11-1977

STATE OF KANSAS

COUNTY OF SEDGWICK

I, James C. Remsberg, of the Slawson Drilling Company hereby state that the above and foregoing is a true and accurate copy of the log of the Eaton 'P' No. 1.

James C. Remsberg
James C. Remsberg

Subscribed and sworn to me this 8th day of October, 1977

Mary Lou Taylor
Mary Lou Taylor, Notary

