


STATE OF KANSAS
STATE CORPORATION COMMISSION

Give All Information Completely
Make Required Affidavit
Mail or Deliver Report to:
Conservation Division
State Corporation Commission
800 Bittling Building
Wichita, Kansas

15-101-00051-00-00
WELL PLUGGING RECORD

NORTH

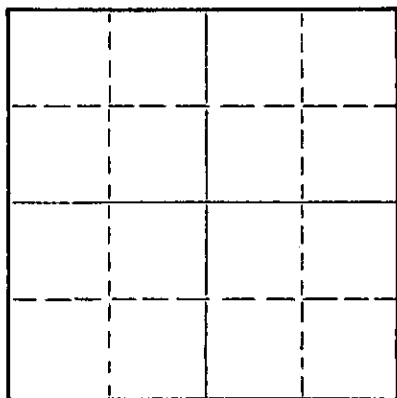

Locate well correctly on above
Section Plat

LANE County. Sec. 25 Twp. 16S Rge. (E) 29 (W)
Location as "NE/CNW/SW" or footage from lines C SW SW
Lease Owner ALLEN OLDHAM
Lease Name EATON Well No. 1
Office Address 514 ORPHEUM BLDG., WICHITA, KANSAS
Character of Well (completed as Oil, Gas or Dry Hole) DRY HOLE
Date well completed 11-5 19 63
Application for plugging filed PHONE 11-5 LETTER 11-8 19 63
Application for plugging approved PHONE 11-5-63 19
Plugging commenced 11-6 19 63
Plugging completed 11-6 19 63
Reason for abandonment of well or producing formation

If a producing well is abandoned, date of last production 19
Was permission obtained from the Conservation Division or its agents before plugging was commenced? YES

Name of Conservation Agent who supervised plugging of this well W. L. NICHOLS
Producing formation Depth to top Bottom Total Depth of Well 4650 Feet
Show depth and thickness of all water, oil and gas formations.

OIL, GAS OR WATER RECORDS

CASING RECORD

FORMATION	CONTENT	FROM	TO	SIZE	PUT IN	PULLED OUT
				8-5/8	274'	NONE

Describe in detail the manner in which the well was plugged, indicating where the mud fluid was placed and the method or methods used in introducing it into the hole. If cement or other plugs were used, state the character of same and depth placed, from feet to feet for each plug set.

FILLED HOLE WITH HEAVY MUD TO 600 FEET.

SET FIRST PLUG AT 600 FEET WITH 20 SACKS CEMENT.

FILLED HOLE WITH HEAVY MUD TO 240 FEET.

SET SECOND PLUG AT 240 FEET WITH 20 SACKS CEMENT.

FILLED HOLE WITH HEAVY MUD TO 40 FEET.

SET THIRD PLUG WITH 10 SACKS OF CEMENT.

PLUGGED RAT HOLE WITH 2 SACKS CEMENT.

(If additional description is necessary, use BACK of this sheet)

Name of Plugging Contractor GABBERT-JONES INC.
Address 514 ORPHEUM BLDG., WICHITA, KANSAS, 67202

STATE OF KANSAS, COUNTY OF SEDGWICK, ss.
E. E. HALL (employee of owner) or (owner or operator) of the above-described well, being first duly sworn on oath, says: That I have knowledge of the facts, statements, and matters herein contained and the log of the above-described well as filed and that the same are true and correct. So help me God.

(Signature) E. E. Hall
514 ORPHEUM BLDG., WICHITA, KANSAS
(Address)

SUBSCRIBED AND SWORN TO before me this 8TH day of NOVEMBER 19 63

My commission expires OCTOBER 2, 1967

VIRA A. MCKENZIE Notary Public.

15-101-00051-00-00

GABBERT-JONES INC.
WICHITA, KANSAS
DRILLERS WELL LOG

EATON #1
 C SW SW SECTION 25-16S-29W
 LANE COUNTY, KANSAS

COMMENCED: OCTOBER 23, 1963
 COMPLETED: NOVEMBER 6, 1963

OPERATOR - ALLEN OLDHAM & ASSOCIATES

<u>DEPTH</u>		<u>FORMATION</u>	<u>REMARKS</u>
FROM	TO		
0	100	CLAY	
100	155	SAND	
155	610	SHALE	RAN 7 JOINTS 8-5/8" CASING, SET @ 255' W/ 200 BAGS CEMENT
610	680	SAND STREAKS	
680	725	SHALE, SHELLS	
725	1230	SHALE, SAND	
1230	1690	SHALE & RED BED	
1690	2194	SHALE	
2194	2230	ANHYDRITE	
2230	2250	SHALE	
2250	2650	LIME & SHALE	
2650	2845	LIME W/ SHALE	
2845	3090	LIME & SHALE	
3090	3250	LIME	
3250	3370	LIME & SHALE	
3370	3547	LIME	
3547	3610	LIME & SHALE	
3610	4650	LIME	
4650	TD		DRY & ABANDONED

I, E. E. HALL, CERTIFY THIS IS A CORRECT COPY OF THE DRILLER'S LOG FOR THE WELL DRILLED IN C SW SW SECTION 25-16S-29W, LANE COUNTY, KANSAS, TO THE BEST OF MY KNOWLEDGE AND BELIEF.

E. E. Hall
 E. E. HALL

STATE OF KANSAS)
) SS
 COUNTY OF SEDGWICK)

BEFORE ME, THE UNDERSIGNED, A NOTARY PUBLIC WITHIN AND FOR SAID COUNTY AND STATE, ON THIS 8TH DAY OF NOVEMBER, 1963, PERSONALLY APPEARED E. E. HALL TO ME PERSONALLY KNOWN TO BE THE IDENTICAL PERSON WHO EXECUTED THE WITHIN AND FOREGOING INSTRUMENT AND ACKNOWLEDGED TO ME THAT HE EXECUTED THE SAME AS HIS FREE AND VOLUNTARY ACT AND DEED FOR THE USES AND PURPOSES THEREIN SET FORTH.

IN WITNESS WHEREOF, I HAVE HEREUNTO SET MY OFFICIAL HAND AND SEAL THE DAY AND YEAR LAST ABOVE WRITTEN.

MY COMMISSION EXPIRES OCTOBER 2, 1967

Vira A. McKenzie
 VIRA A. MCKENZIE, NOTARY PUBLIC