

AFFIDAVIT OF COMPLETION FORM

-1 WELL HISTORY

TYPE

Compt. _____

SIDE ONE

COPY

Two (2) copies of this form shall be filed with the Kansas Corporation Commission, 200 Colorado Derby Building, Wichita, Kansas 67202, within thirty (30) days after the completion of a well, regardless of how the well was completed.

F Attach separate letter of request if the information is to be held confidential. If confidential, only file one copy. Information on Side One will be of public record and Side Two will then be held confidential.

Applications must be made on dual completion, commingling, salt water disposal, injection and temporarily abandoned wells.

C Attach one copy only wireline logs (i.e. electrical log, sonic log, gamma ray neutron log, etc.). (Rules 82-2-105 & 82-2-125) KCC# (316) 263-3238.

LICENSE # 5886 EXPIRATION DATE 6-30-83

OPERATOR Chief Drilling Co., Inc. API NO. 15-101-20.776-00-00

ADDRESS 905 Century Plaza Wichita, Ks. 67202 COUNTY Lane

** CONTACT PERSON F.W. Shelton, Jr., Vice Pres. PROD. FORMATION PHONE 316-262-3791

PURCHASER Koch Oil Company LEASE YATES

ADDRESS Box 2256 WELLS NO. #1

Wichita, Ks. 67201 WELLS LOCATION NW SE NW of Sec.

DRILLING Contractor Warrior Drilling Co., Rig #2 1650 Ft. from North Line and

ADDRESS 905 Century Plaza 1650 Ft. from West Line of Sec.

Wichita, Ks. 67202 the (Qtr.) SEC 23 TWP 16S RGE 29W(W)

PLUGGING CONTRACTOR ADDRESS NONE

TOTAL DEPTH 4578 RTD 4579 LTDBTD no

SPUD DATE 4-25-83 DATE COMPLETED 5-06-83

ELEV: GR 2788 DF 2792 KB 2795


DRILLED WITH (XKDC) (ROTARY) (XRX) TOOLS.

DOCKET NO. OF DISPOSAL OR REPRESSURING WELL BEING USED TO DISPOSE OF WATER FROM THIS LEASE .. none

Amount of surface pipe set and cemented 281' set @ DV Tool Used? no

THIS AFFIDAVIT APPLIES TO: (Circle ONE) - Oil Gas, Shut-in Gas, Dry, Disposal, Injection, Temporarily Abandoned, OWWO. Other

ALL REQUIREMENTS OF THE STATUTES, RULES AND REGULATIONS PROMULGATED TO REGULATE THE OIL AND GAS INDUSTRY HAVE BEEN FULLY COMPLIED WITH.

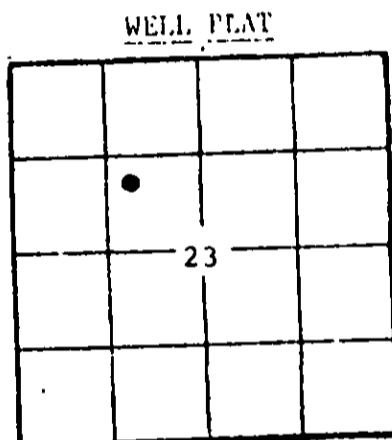

WELL PLAT (Office Use Only) KCC KCS SWD/REP PLG.

AFFIDAVIT


F.W. SHELTON, JR., VICE PRESIDENT, being of lawful age, hereby certifies that:

I am the Affiant, and I am familiar with the contents of the foregoing Affidavit. The statements and allegations contained therein are true and correct.

F.W. Shelton, Jr., Vice Pres. (Name)

SUBSCRIBED AND SWORN TO BEFORE ME this 11th day of July

19 83.

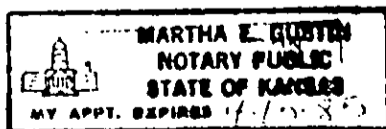

(NOTARY PUBLIC) Martha E. Gustin

MY COMMISSION EXPIRES:

** The person who can be reached by phone regarding any questions concerning this information.

STATE REC AUG 21 1985 08-21-1985 GUSTIN Martha E. Gustin Wichita, Kansas