

CARD MUST BE TYPED

State of Kansas

CARD MUST BE SIGNED

NOTICE OF INTENTION TO DRILL

(see rules on reverse side)

Expected Spud Date: 10 month 1 day 87 year

API Number 15-101-21,422-00-00

OPERATOR: License # 5151
Name Gear Petroleum Co., Inc.
Address 1075 KSB Bldg-125 N. Market
City/State/Zip Wichita, KS 67202
Contact Person Jim Thatcher
Phone 316-265-3351

C NE NW Sec. 9 Twp. 16 S. Rg. 27 X East West
4620 Ft. from South Line of Section
3300 Ft. from East Line of Section

(Note: Locate well on Section Plat on reverse side)

CONTRACTOR: License # 5302
Name Red Tiger Drilling Company
City/State Wichita, KS

Nearest lease or unit boundary line 660 feet
County Lane

Well Drilled For: Well Class: Type Equipment:
X Oil Storage Infield Mud Rotary
Gas Inj Pool Ext. Air Rotary
OWWO Expl Wildcat Cable

Lease Name Rod Well # 1-9
Ground surface elevation unknown feet MSL
Domestic well within 330 feet: yes X no
Municipal well within one mile: yes X no
Depth to bottom of fresh water 200
Depth to bottom of usable water 1100
Surface pipe by Alternate: 320' 1 2 X
Surface pipe planned to be set
Conductor pipe required n/a
Projected Total Depth 4600 feet
Formation Mississippian

If OWWO: old well info as follows:

Operator
Well Name
Comp Date Old Total Depth

I certify that well will comply with K.S.A. 55-101, et seq., plus eventually plugging hole to KCC specifications.

Date 9/23/87 Signature of Operator or Agent Jim Thatcher Title Dir. & Prod. Manager

For KCC Use:


Conductor Pipe Required feet; Minimum Surface Pipe Required 200 feet per Alt. X 2
This Authorization Expires 3-24-88 Effective Approved By 9-24-87 9-29-87

Must be filed with the K.C.C. five (5) days prior to commencing well
This card void if drilling not started within six (6) months of date received by K.C.C.

Important procedures to follow:

1. Notify District office before setting surface casing.
2. Set surface casing by circulating cement to the top.
3. File completion forms ACO-1 with K.C.C. within 120 days of well spud date, following instructions on ACO-1, side 1, and including copies of wireline logs.
4. Notify District office 48 hours prior to old well workover or re-entry.
5. Prior to filing Intent, prepare a proposed plugging plan in case well is D & A, then obtain approval of plan when calling district office prior to setting surface pipe.
6. Submit plugging report (CP-4) to K.C.C. after plugging is completed.
7. Obtain an approved injection docket number before disposing of salt water.
8. Notify K.C.C. within 10 days when injection commences or terminates.
9. If an alternate 2 completion, cement in the production pipe from below any usable water to surface within 120 days of spud date.

A Regular Section of Land
1 Mile = 5,280 Ft.

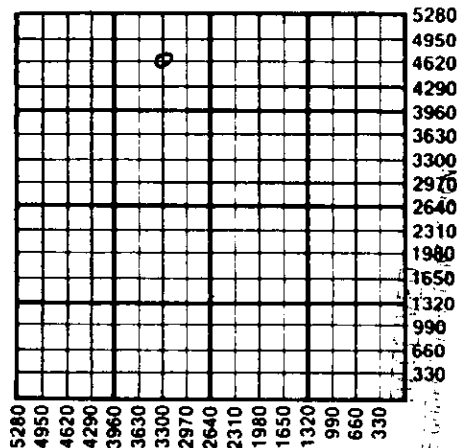

STATE WATER

SEP 24 1987

Office of State Geologist
Wichita, Kansas

09-24-1987

State Corporation Commission of Kansas
Conservation Division
200 Colorado Derby Building
Wichita, Kansas 67202-1212
(316) 263-3235