


15-101-20108-00-00

STATE OF KANSAS  
STATE CORPORATION COMMISSION  
CONSERVATION DIVISION  
P. O. BOX 17027  
WICHITA, KANSAS 67217

FORM CP-4

WELL PLUGGING RECORD

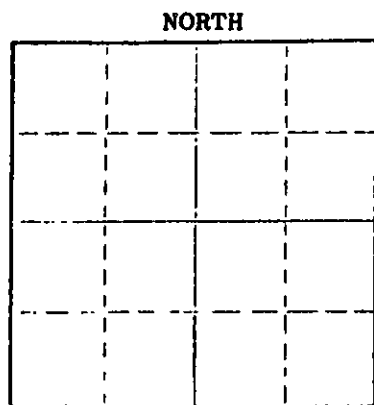

Locate well correctly on above Section Plat

Lane \_\_\_\_\_ County, Sec. 30 Twp. 18S Rge. (E) 28W  
Location as "NE/CNW/SE/SW" or footage from lines C E/2 NW NE  
Lease Owner D N B DRILLING, INC.  
Lease Name Ware Well No. 1  
Office Address 701 First Nat'l Bldg., Wichita, Ks. 67202  
Character of Well (completed as Oil, Gas or Dry Hole) Dry Hole  
Date well completed 7-13 19 74  
Application for plugging filed 7-13 19 74  
Application for plugging approved 7-13 19 74  
Plugging commenced 7-13 19 74  
Plugging completed 7-13 19 74  
Reason for abandonment of well or producing formation No commercial quantities of oil or gas encountered  
If a producing well is abandoned, date of last production 19  
Was permission obtained from the Conservation Division or its agents before plugging was commenced? Yes

Name of Conservation Agent who supervised plugging of this well W. L. Nichols  
Producing formation \_\_\_\_\_ Depth to top \_\_\_\_\_ Bottom \_\_\_\_\_ Total Depth of Well 4610 Feet  
Show depth and thickness of all water, oil and gas formations.

OIL, GAS OR WATER RECORDS				CASING RECORD		
FORMATION	CONTENT	FROM	TO	SIZE	PUT IN	PULLED OUT
Surface Hole	Water	Surface	308	8-5/8"	300'	None

Describe in detail the manner in which the well was plugged, indicating where the mud fluid was placed and the method or methods used in introducing it into the hole. If cement or other plugs were used, state the character of same and depth placed, from \_\_\_\_\_ feet to \_\_\_\_\_ feet for each plug set.

Fluid to 850', plug, 70 sx cement;  
Fluid to 310', plug, 20 sx cement;  
Fluid to 40', plug, 1/2 sx hulls, 10 sx cement.

(If additional description is necessary, use BACK of this sheet)  
Name of Plugging Contractor D N B DRILLING, INC.  
Address 701 First Nat'l Bldg., Wichita, Kansas 67202

STATE OF KANSAS COUNTY OF \_\_\_\_\_ SS.  
JAMES L. DONELSON (employee of owner) or (owner or operator) of the above-described

well, being first duly sworn on oath, says: That I have knowledge of the facts, statements, and matters herein contained and the log of the above-described well as filed and that the same are true and correct. So help me God.

(Signature) James L. Donelson  
701 First Nat'l Bldg., Wichita, Ks.  
(Address)

SUBSCRIBED AND SWORN TO before me this 15th day of July 19 74

My commission expires August 25, 1976

Ella Priess  
Ella Priess Notary Public.

RECEIVED  
STATE CORPORATION COMMISSION  
JUL 19 1974  
CONSERVATION DIVISION  
Wichita, Kansas

Ella Priess  
STATE NOTARY PUBLIC  
Sedgwick County, Kansas  
My Com. Expires Aug. 25, 1976

15-101-20108-00-00

DRILLERS' LOG

D N B DRILLING, INC.  
No. 1 Ware  
CE/2 NW NE, Sec. 30-18S-28W  
Lane County, Kansas

Elevation: 2730 K.B.

Commenced: 7-6-74  
Completed: 7-13-74

Surface Casing: 300' of  
8-5/8" cemented w/200 sx  
common cement, 2% Gel, 3%  
cc. 7-6-74

FORMATION

DEPTH

Surface Hole	0 - 308
Shale	308 - 820
Shale & Sand	820 - 1547
Blaine Anhydrite	1547 - 1557
Shale	1557 - 1610
Sand	1610 - 1835
Shale	1835 - 2107
Anhydrite	2107 - 2134
Shale	2134 - 2580
Lime & Shale	2580 - 3690
Lime	2690 - 4610 T.D.

RECEIVED  
STATE CORPORATION COMMISSION  
JUL 19 1974  
CONSERVATION DIVISION  
Wichita, Kansas

I do hereby certify that the foregoing statements are true and correct to the best of my knowledge and belief.

D N B DRILLING, INC.

*James L. Donelson*  
JAMES L. DONELSON

STATE OF KANSAS: ss:

Subscribed and sworn to before me, the undersigned, a Notary Public in and for said state, this 15th day of July, 1974.

My Commission Expires:  
August 25, 1976

*Ella Priess*  
Ella Priess, Notary Public

*Ella Priess*  
STATE NOTARY PUBLIC  
Sedgwick County, Kansas  
My Com. Expires Aug. 25, 1976