


WELL PLUGGING RECORD

15-101-20738-00-00

Give All Information Completely
Make Required Affidavit

COUNTY Lane SEC. 25 TWP. 18s RGE. 28w xx' W
Location as in quarters or footage from lines:
NW NE NW

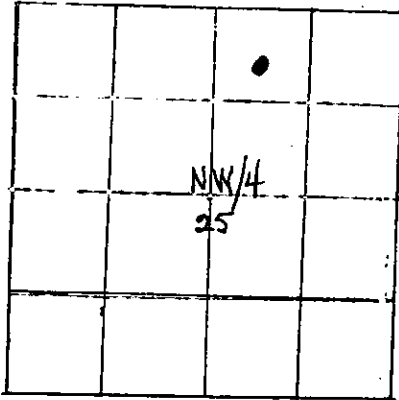

Locate Well
correctly on above
Section Platt.

Lease Owner Petromark Exploration, Inc.
Lease Name Alamota Well No. 25-1
Office Address 7170 South Braden, Suite 200, Tulsa, OK 74136
Character of Well (Completed as Oil, Gas or Dry Hole): Dry Hole
Date Well Completed 2-28-83
Application for plugging filed 2-28-83
Plugging commenced 2-28-83
Plugging completed 2-28-83 8:00 p.m.
Reason for abandonment of well or producing formation Dry & abandoned

Was permission obtained from the Conservation Division or it's
Agent's before plugging was commenced? yes

Name of Conservation Agent who supervised plugging of this well Steve Durrant

Producing formation _____ Depth to top _____ bottom T.D. 4572

Show depth and thickness of all water, oil and gas formations.

OIL, GAS OR WATER RECORDS

Casing Record

| Formation | Content | From | To | Size | Put in | Pulled Out. |
|-----------|---------|------|----|--------|--------|-------------|
| | | | | 8 5/8" | 282' | none |
| | | | | | | |
| | | | | | | |
| | | | | | | |

Describe in detail the manner in which the well was plugged, indicating where the mud fluid was placed and the method or methods used in introducing it into the hold. If cement or other plugs were used, state the character of same and depth placed, from _____ feet to _____ feet for each plug set.

1st plug 70 sx @ 2040'
2nd plug 50 sx @ 1020'
3rd plug 40 sx @ 330'
4th plug 10 sx @ 40' w/ bridge
10 sx in rathole

180 sx 50/50 poz, 4% gel, 3% cc

(If additional description is necessary, use BACK of this sheet)

Name of Plugging Contractor Mustang Drilling & Exploration, Inc.

STATE OF Kansas COUNTY OF Barton, ss.

Gib Overbey (employee of owner) or (owner or operator) of the above-described well, being first duly sworn on oath, says: That I have knowledge of the facts, statements, and matters herein contained and the log of the above-described well as filed and that the same are true and correct. So help me God.

(Signature) Gib Overbey
P.O. Box 1609, Great Bend, KS
(Address)

SUBSCRIBED AND SWORN TO before me this 23rd day of March, 19 83



Pam Shaffer
STATE CORPORATION COMMISSION Notary Public.

My Commission expires: 9-30-86

MAR 20 1983