

15-101-20758-00-00

STATE OF KANSAS
STATE CORPORATION COMMISSION

WELL PLUGGING RECORD

Give All Information Completely
Make Required Affidavit
Mail or Deliver Report to
Conservation Division
State Corporation Comm.
245 North Water
Wichita, KS 67202

 Lane County. Sec. 2 Twp. 18S Rge. 28W E/W
Location as "NE/CNW $\frac{1}{4}$ /SW $\frac{1}{4}$ " or footage from lines
SE SE NW

Lease Owner Chief Drilling Co.
Lease Name Niles Well No. 1

Office Address 905 Century Plaza, Wichita, Kansas 67202

Character of Well (Completed as Oil, Gas or Dry Hole)
Dry Hole

Date Well completed February 15, 1983

Application for plugging filed February 15, 1983

Application for plugging approved February 15, 1983

Plugging commenced February 15, 1983

Plugging completed February 15, 1983

Reason for abandonment of well or producing formation
Dry Hole


If a producing well is abandoned, date of last production
19

Was permission obtained from the Conservation Division or its agents before plugging was commenced? yes

Name of Conservation Agent who supervised plugging of this well Bob Tarbottom

Producing formation Depth to top Bottom Total Depth of Well 4560'

Show depth and thickness of all water, oil and gas formations.

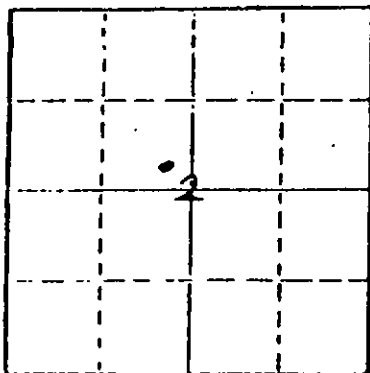

Locate well correctly on above Section Plot

OIL, GAS OR WATER RECORDS

CASING RECORD

FORMATION	CONTENT	FROM	TO	SIZE	PUT IN	PULLED OUT

Describe in detail the manner in which the well was plugged, indicating where the mud fluid was placed and the method or methods used in introducing it into the hold. If cement or other plugs were used, state the character of same and depth placed, from feet to feet for each plug set.

Plugged w/ 50 sks @ 2070'
50 sks @ 1035'
40 sks @ 390'
10 sks @ 40' w/ hulls & plug
10 sks Mouse hole, 10 sks Rat hole


Cement: 50-50 Pozmix 4% Gel, 3% CC

(If additional description is necessary, use BACK of this sheet)

Name of Plugging Contractor Allied Cement

STATE OF Kansas COUNTY OF Sedgwick, ss.
Jerome D. Marcus (employee of owner) or (owner or operator)

of the above-described well, being first duly sworn on oath, says: That I have knowledge of the facts, statements, and matters herein contained and the log of the above-described well as filed and that the same are true and correct. So help me God.

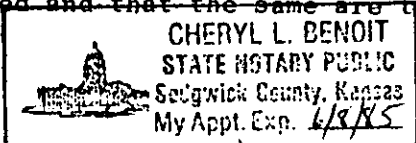

(Signature) [Signature]
401 E. Douglas, Suite #402, Wichita, Kansas 67202
(Address)

SUBSCRIBED AND SWORN TO before me this 22rd day of February, 19 83

My commission expires 6/8/85

STATE OF KANSAS RECEIVED
CONSERVATION COMMISSION
FEB 25 1983
CONSERVATION DIVISION
Wichita, Kansas

CHIEF DRILLING CO., Inc.

Drilling Contractors - Oil Producers

SUITE 905 CENTURY PLAZA
WICHITA, KANSAS 67202

15-101-20758-00-00

V. RICHARD HOOVER
PRESIDENT

DAILY DRILLING REPORT

(316) 262-3791

NILES #1

SE SE NW Sec. 2-18S-28W

LANE COUNTY, KANSAS

- 2-7-83 Moved in, Ran 8 jts. 20#, 8 5/8" set @ 327', cemented w/225 sx. 60-40 pos mix, 2% gel, 3% c.c., cement circulated Plug down @ 11:35 p.m. by Allied Cement
- 2-8-83 Drilling on surface
- 2-9-83 Drilling @ 2290'
- 2-10-83 Drilling @ 3145'
- 2-11-83 Drilling @ 3947'
- 2-12-83 DST #1 4180 - 4213 (200 zone) 30-30-60-45 wk. blow for 10", then fair blow for 80". 10" afterblow on FSIP: Rec.: 30' VSOCM, 270' MW IBHP: 1130#, FBHP: 1110#, FP: 50-130 150 - 290
- 2-13-83 DST #2 (Ft. Scott & Cherokee) 4447 - 4530 30-30-30-30 very weak blow for 25 min., Rec. 10' OSM, IBHP: 825#, FBHP: 525#, FP: 70 - 70
- 2-14-83 T.D. 4560' Plugged w/50 sx. @ 2070', 50 sx. @ 1035', 40 sx. @ 390', @ 40', hulls, plug & 10 sx., 10 sx. in rat hole, 10 sx. in mouse hole, cemented w/50-50 pos mix, 4% gel, 3% c.c., Plug down @ 5:00 p.m. State Plugger Bob Tarbottom

ELEVATION:

2653 GR.
2656 D.F.
2658 K.B.

FORMATION TOPS:

Anhydrite	2059	+	599
Base Anhydr.	2095	+	563
Heebner	3888	-	1230
Lansing	3926	-	1268
Muncie Creek	4097	-	1439
Stark	4194	-	1536
Hush Puckney	4228	-	1570
BKC	4268	-	1610
Pawnee	4383	-	1725
Ft. Scott	4444	-	1786
Cherokee	4468	-	1810
Mississippi	4528	-	1870
RTD	4560	-	1992

LOG TOPS:

Anhydrite	2059	+	599
Base Anhydr.	2088	+	570
Heebner	3888	-	1230
LKC	3926	-	1268
Muncie Cr.	4093	-	1435
Stark	4188	-	1530
Hush Puckney	4222	-	1564
BKC	4266	-	1608
Pawnee	4384	-	1726
Ft. Scott	4444	-	1786
Cherokee	4466	-	1808
LTD	4563	-	1995

RECEIVED
STATE CORPORATION COMMISSION

FEB 25 1983

CONSERVATION DIVISION
Wichita, Kansas