


15-101-20933-00-00

STATE OF KANSAS
STATE CORPORATION COMMISSION

WELL PLUGGING RECORD

Give All Information Completely
Make Required Affidavit
Mail or Deliver Report to
Conservation Division
State Corporation Comm.
245 North Water
Wichita, KS 67202

Lane _____ County, Sec. 24 Twp. 16S Rge. 27 E/W
Location as "NE/CNW 1/4 SW 1/4" or footage from lines _____
NE NW NE
Lease Owner McDonald-Wallace Petroleum # 6390
Lease Name McBee Well No. 1
Office Address 212 N. Market Suite 509 Wichita, KS 67202
Character of Well (Completed as Oil, Gas or Dry Hole) _____

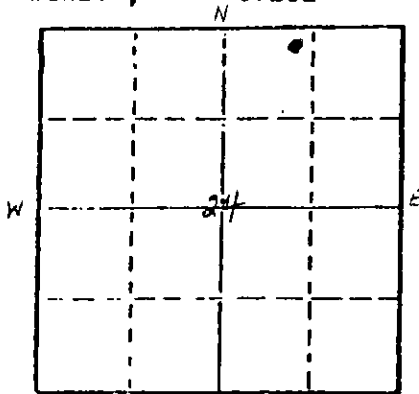

Locate well correctly on above Section Plat

Dry Hole
Date Well completed _____ 2-23- 19 84
Application for plugging filed _____ 2-23- 19 84
Application for plugging approved _____ 2-23- 19 84
Plugging commenced _____ 2-23- 19 84
Plugging completed _____ 2-23- 19 84
Reason for abandonment of well or producing formation _____

Dry Hole
If a producing well is abandoned, date of last production _____ 19 _____

Was permission obtained from the Conservation Division or its agents before plugging was commenced? YES

Name of Conservation Agent who supervised plugging of this well Steve Durrant
Producing formation _____ Depth to top _____ Bottom _____ Total Depth of Well 4583'
Show depth and thickness of all water, oil and gas formations.

OIL, GAS OR WATER RECORDS

CASING RECORD

FORMATION	CONTENT	FROM	TO	SIZE	PUT IN	PULLED OUT
Surface		0	347'	8 5/8	344'	0

Describe in detail the manner in which the well was plugged, indicating where the mud fluid was placed and the method or methods used in introducing it into the hold. If cement or other plugs were used, state the character of same and depth placed, from _____ feet to _____ feet for each plug set.

4583' T.D. 160 Sacks 60/40 Posmix 3% cc 2% Gel
1st Plug at 2060' with 50 Sacks
2nd Plug at 1080' with 50 Sacks
3rd Plug at 360' with 40 Sacks
Solid Bridge & Hulls at 40' with 10 Sacks
Circulated thru jointed drill pipe in Rathole 10 Sacks
Plug down at 2:00 A.M. 2-23-84

(If additional description is necessary, use BACK of this sheet)

Name of Plugging Contractor Blue Goose Drilling Company, Inc. # 5104

STATE OF KANSAS COUNTY OF BARTON, ss.
George E. Miller, Jr. (employee of owner) or (owner or operator)
of the above-described well, being first duly sworn on oath, says: That I have knowledge of the facts, statements, and matters herein contained and the log of the above-described well as filed and that the same are true and correct. So help me God.

(Signature) George E. Miller, Jr.
P.O. Box 1413 Great Bend, KS 67530
(Address)

SUBSCRIBED AND SWORN TO before me this 24th day of February, 19 84

Helen C. Standley
Helen C. Standley Notary Public.

My commission expires 12-8-87

RECEIVED
STATE CORPORATION COMMISSION
MAR 30 1984

HELEN C. STANDLEY
Barton County, Kansas
My Appt. Exp. 12-8-87

CONSERVATION DIVISION
Wichita, Kansas

15-101-20933-00-00

WELL LOG

MC BEE # 1
NE NW NE Section 24-16S-27W
Lane County, KS

NAME OF OPERATOR: McDonald-Wallace Petroleum Co., Inc. # 6390
509 Landmark Square
212 North Market
Wichita, KS 67202

DATE COMPLETED: February 23, 1984

FROM	TO	
0	347	Post Rock & Clay
347	694	Sand and Shale
694	1410	Shale
1410	2380	Sand and Shale
2380	4205	Lime and Shale
4205	4260	Lime
4260	4335	Lime and Shale
4335	4470	Lime
4470	4583	Lime and Shale
4583	T.D.	

STATE OF KANSAS

COUNTY OF BARTON ss

George E. Miller, Jr., President of Blue Goose Drilling Company, Inc. being first duly sworn on oath says: That I have knowledge of the facts, statements and matters herein contained and the log of the above described well as filed and that the same are true and correct.

George E. Miller, Jr.
George E. Miller, Jr.

Subscribed and sworn before me this 28th Day of February 1984.



Helen C. Standley
Helen C. Standley, Notary Public

My Commission Expires: 12-8-87

RECEIVED
STATE CORPORATION COMMISSION
MAR 30 1984
CONSERVATION DIVISION
Wichita, Kansas