


WELL PLUGGING RECORD

Give All Information Completely
Make Required Affidavit
Mail or Deliver Report to:
Conservation Division
State Corporation Commission
P. O. Box 17027
Wichita, Kansas 67217
NORTH

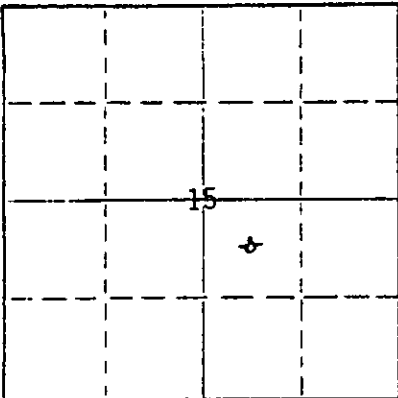

Locate well correctly on above Section Plat

Lane _____ County. Sec. 15 Twp. 16 Rge. (E) 27W (W)
Location as "NE/CNW/SW" or footage from lines C NW SE
Lease Owner AGIP PETROLEUM CO., INC. Donald C. Slawson, agent
Lease Name Broughton 'P' Well No. 1
Office Address 200 Douglas Building Wichita, Kansas 67202
Character of Well (completed as Oil, Gas or Dry Hole) Dry Hole
Date well completed March 20, 19 82
Application for plugging filed March 20, 19 82
Application for plugging approved March 20, 19 82
Plugging commenced March 20, 19 82
Plugging completed March 20, 19 82
Reason for abandonment of well or producing formation Dry Hole

If a producing well is abandoned, date of last production _____ 19____
Was permission obtained from the Conservation Division or its agents before plugging was commenced? Yes

Name of Conservation Agent who supervised plugging of this well Marion Schmidt
Producing formation _____ Depth to top _____ Bottom _____ Total Depth of Well 4620 Feet
Show depth and thickness of all water, oil and gas formations.

OIL, GAS OR WATER RECORDS

CASING RECORD

FORMATION	CONTENT	FROM	TO	SIZE	PUT IN	PULLED OUT
		surface	328'	8 5/8"		

Describe in detail the manner in which the well was plugged, indicating where the mud fluid was placed and the method or methods used in introducing it into the hole. If cement or other plugs were used, state the character of same and depth placed, from _____ feet to _____ feet for each plug set.

1st plug @ 1080' w/70 sx
2nd plug @ 500' w/40 sx
Solid Bridge @ 40' w/10 sx
10 sx in Rat Hole

(If additional description is necessary, use BACK of this sheet)
Name of Plugging Contractor Halliburton Services
Address Box 579 Great Bend, Kansas 67530

STATE OF KANSAS, COUNTY OF SEDGWICK
William R. Horigan (employee of powder) or (owner or operator) of the above-described well, being first duly sworn on oath, says: That I have knowledge of the facts, statements, and matters herein contained and the log of the above-described well as filed and that the same are true and correct. So help me God.

(Signature) William R. Horigan 5-18-82
William R. Horigan
200 Douglas Building Wichita, Kansas 67202
(Address)



Subscribed and sworn to before me this 26th day of April, 19 82
Sherry L. Kendall
Sherry L. Kendall Notary Public.

My commission expires 06/12/82