

STATE CORPORATION COMMISSION OF KANSAS
OIL & GAS CONSERVATION DIVISION

WELL COMPLETION OR RECOMPLETION FORM
ACO-1 WELL HISTORY

DESCRIPTION OF WELL AND LEASE

Operator: license # 5363
name BEREEXO INC.
address 970 Fourth Financial Center
City/State/Zip Wichita, KS. 67202

Operator Contact Person David Munro
Phone 316-265-3311

Contractor: license # 5147
name BEREDCO INC.

Wellsite Geologist P. Sam Houston
Phone (316) 262-1163

PURCHASER N/A

Designate Type of Completion
 New Well Re-Entry Workover

Oil SWD Temp Abd
 Gas Inj Delayed Comp.
 Dry Other (Core, Water Supply etc.)

If OWWO: old well info as follows:
Operator
Well Name
Comp. Date Old Total Depth

WELL HISTORY

Drilling Method: Mud Rotary Air Rotary Cable
6/08/87 6/14/87 6/14/87
Spud Date Date Reached TD Completion Date

4300'
Total Depth PBDT

Amount of Surface Pipe Set and Cemented at 385' feet

Multiple Stage Cementing Collar Used? Yes No

If Yes, Show Depth Set feet

If alternate 2 completion, cement circulated
from feet depth to w/ SX cmt

API NO. 15 - 135-23,129 -00-00
County NESS
NW NW NW Sec 2 Twp 16S Rge 21 East West
4950 Ft North from Southeast Corner of Section
4950 Ft West from Southeast Corner of Section
(Note: locate well in section plat below)


Lease Name Sarvis Well# 1

Field Name

Producing Formation

Elevation: Ground 2309 KB 2314

Section Plat

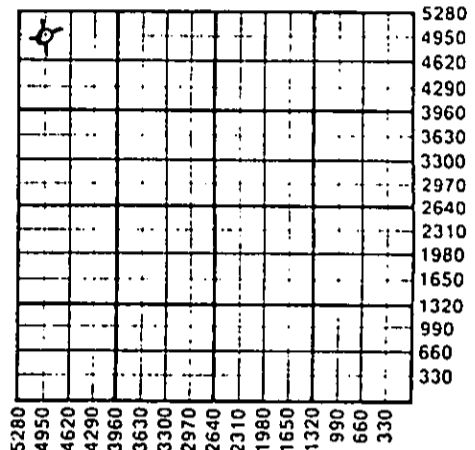

WATER SUPPLY INFORMATION

Source of Water: Hauled
Division of Water Resources Permit #

Groundwater Ft North From Southeast Corner and
(Well) Ft. West From Southeast Corner of
Sec Twp Rge East West

Surface Water Ft North From Southeast Corner and
(Stream, Pond etc.) Ft West From Southeast Corner
Sec Twp Rge East West

Other (explain)
(purchased from city, R.W.D.#)

Disposition of Produced Water: Disposal Repressuring

Docket #

INSTRUCTIONS: This form shall be completed in duplicate and filed with the Kansas Corporation Commission, 200 Colorado Derby Building, Wichita, Kansas 67202, within 90 days after completion or recompletion of any well. Rules 82-3-130 and 82-3-107 apply.

Information on side two of this form will be held confidential for a period of 12 months if requested in writing and submitted with the form. See rule 82-3-107 for confidentiality in excess of 12 months.

One copy of all wireline logs and drillers time log shall be attached with this form. Submit CP-4 form with all plugged wells. Submit CP-111 form with all temporarily abandoned wells.

All requirements of the statutes, rules, and regulations promulgated to regulate the oil and gas industry have been fully complied with and the statements herein are complete and correct to the best of my knowledge.

Signature [Signature]
Title District Engineer Date 6/29/87

Subscribed and sworn to before me this 29th day of June 19 87

Notary Public Kathryn A. Voigt
Date Commission Expires 6/13/89

KATHRYN A. VOIGT
NOTARY PUBLIC
STATE OF KANSAS
My Appt. Expires 6-13-89

K.C.C. OFFICE USE ONLY
 Letter of Confidentiality Attached
 Wireline Log Received
 Drillers Timelog Received
Distribution
 KCC SWD/Rep NGPA
 KGS Plug Other
STATE CORPORATION COMMISSION (Specify)
JUN 29 1987

07-02-1987
Form ACO-1 (7-84)
Wichita, Kansas

Sec. 2, Twp. 16S, Rge. 21E