


Give All Information Completely  
Make Required Affidavit  
Mail or Deliver Report to:  
Conservation Division  
State Corporation Commission  
211 No. Broadway  
Wichita, Kansas

WELL PLUGGING RECORD

NORTH

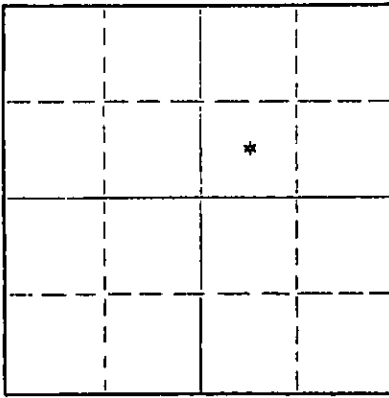

Locate well correctly on above  
Section Plat

Lane \_\_\_\_\_ County. Sec. 19 Twp. 19S Rge. 28 (E)X(W)  
Location as "NE/CNWxSWx" or footage from lines C-SW-NE  
Lease Owner Davis Brothers Oil Producers  
Lease Name Hineman "B" Well No. 1  
Office Address Tulsa, Oklahoma  
Character of Well (completed as Oil, Gas or Dry Hole) Dry Hole  
Date well completed 12-13 19 62  
Application for plugging filed 12-13 19 62  
Application for plugging approved 12-13 19 62  
Plugging commenced 12-13 19 62  
Plugging completed 12-14 19 62  
Reason for abandonment of well or producing formation \_\_\_\_\_

If a producing well is abandoned, date of last production \_\_\_\_\_ 19\_\_\_\_  
Was permission obtained from the Conservation Division or its agents before plugging was commenced? Yes

Name of Conservation Agent who supervised plugging of this well Eldon Petty  
Producing formation \_\_\_\_\_ Depth to top \_\_\_\_\_ Bottom \_\_\_\_\_ Total Depth of Well 4726 Feet  
Show depth and thickness of all water, oil and gas formations.

OIL, GAS OR WATER RECORDS

CASING RECORD

FORMATION	CONTENT	FROM	TO	SIZE	PUT IN	PULLED OUT
		0	150	8 5/8	150	0

Describe in detail the manner in which the well was plugged, indicating where the mud fluid was placed and the method or methods used in introducing it into the hole. If cement or other plugs were used, state the character of same and depth placed, from \_\_\_\_\_ feet to \_\_\_\_\_ feet for each plug set.

Filled hole with heavy mud to 600',  $\frac{1}{2}$  sacks hulls, plug, and 20 sacks cement. Filled hole with heavy mud to 180',  $\frac{1}{2}$  sack hulls, plug and 20 sacks cement. Mud hole up to 35',  $\frac{1}{2}$  sack hulls, plug and 10 sacks cement to surface.

DEC 20 1962

12-20-1962

(If additional description is necessary, use BACK of this sheet)

Name of Plugging Contractor Terrel Drilling and Producing  
Address Russell, Kansas

STATE OF KANSAS, COUNTY OF RUSSELL, ss.  
Joe K. Branum, Contractor, (employee of owner) of the above-described well, being first duly sworn on oath, says: That I have knowledge of the facts, statements, and matters herein contained and the log of the above-described well as filed and that the same are true and correct. So help me God.

(Signature) Joe K. Branum  
Russell, Kansas  
(Address)

SUBSCRIBED AND SWORN TO before me this 17th day of December, 1962

My commission expires November 13, 1963.

Mary Arma Branum  
Notary Public.



15-101-00060-00-00

DEC 20 1962  
12-20-1962

WELL LOG

OPERATOR: Davis Brothers Oil Producers  
Tulsa, Oklahoma

CONTRACTOR: Terrel Drilling & Producing  
Russell, Kansas

LEASE: Hineman "B" # 1

COMMENCED: November 14, 1962

LOCATION: C-SW-NE, Sec. 19-19S-28W  
Lane County, Kansas

COMPLETED: December 13, 1962

DEPTHS & FORMATIONS

Sand & Shale	155	Lime & Shale	3785
Shale	605	Lime	3939
Shale & Shells	1550	Chalk & Lime	4000
Gypsum & Sand	1558	Lime & Shale	4245
Shale	2135	Lime	4628
Anhydrite	2160	Chert & Lime	4667
Lime & Shale	3335	Lime & Chat (R.T.D.)	4726
Lime	3405		

STATE OF KANSAS

COUNTY OF RUSSELL ss

Joe K. Eranum, owner of Terrel Drilling and Producing, being first duly sworn on oath says: That I have knowledge of the facts, statements, and matters herein contained and the log of the above described well as filed and that the same are true and correct.

  
Joe K. Eranum

Subscribed and sworn before me this 17th day of December, 1962.

  
Notary Public

Russell County

My Commission Expires: November 13, 1963.