


STATE OF KANSAS
STATE CORPORATION COMMISSION

WELL PLUGGING RECORD

Give All Information Completely
Make Required Affidavit
Mail or Deliver Report to
Conservation Division
State Corporation Comm.
245 North Water
Wichita, KS 67202

Lane _____ County. Sec. 8 Twp. 19S Rge. 28 E/W
Location as "NE/CNW 1/4 SW 1/4" or footage from lines _____
C W/2 NW SW
Lease Owner Blue Goose Drilling Co., Inc. # 5104
Lease Name Hineman Well No. 1
Office Address Box 1413 Great Bend, KS 67530
Character of Well (Completed as Oil, Gas or Dry Hole) _____

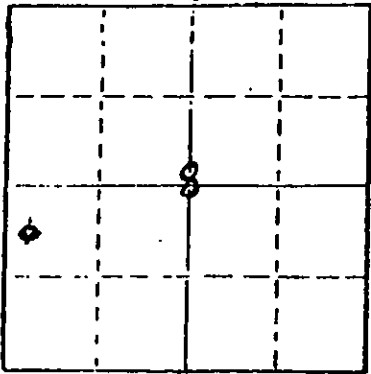

Locate well correctly on above
Section Plat

DRY HOLE
Date Well completed 6-4- 19 84
Application for plugging filed 6-4- 19 84
Application for plugging approved 6-4- 19 84
Plugging commenced 6-4- 19 84
Plugging completed 6-4- 19 84
Reason for abandonment of well or producing formation _____

D & A
If a producing well is abandoned, date of last production 19

Was permission obtained from the Conservation Division or its agents before plugging was commenced? YES

Name of Conservation Agent who supervised plugging of this well Ken Beakey
Producing formation _____ Depth to top _____ Bottom _____ Total Depth of Well 4675'
Show depth and thickness of all water, oil and gas formations.

OIL, GAS OR WATER RECORDS

CASING RECORD

FORMATION	CONTENT	FROM	TO	SIZE	PUT IN	PULLED OUT
Surface		0	371'	8 5/8	369'	0

Describe in detail the manner in which the well was plugged, indicating where the mud fluid was placed and the method or methods used in introducing it into the hold. If cement or other plugs were used, state the character of same and depth placed, from _____ feet to _____ feet for each plug set.

4675' T.D. 170 Sacks 60-40 Posmix 2% Gel 3% cc
1st Plug @ 2120' with 50 Sacks
2nd Plug @ 1375' with 50 Sacks
3rd Plug @ 410' With 50 Sacks
Solid Bridge @ 40' with 10 Sacks
Rathole 10 Sacks
Plug down @ 11:45 A.M. on 6-4-84
Sun Cement

(If additional description is necessary, use BACK of this sheet)

Name of Plugging Contractor Blue Goose Drilling Company, Inc. # 5104


STATE OF KANSAS COUNTY OF BARTON, ss.
George E. Miller, Jr. (~~owner or operator~~) or (owner or operator)
of the above-described well, being first duly sworn on oath, says: That I have knowledge of the facts, statements, and matters herein contained and the log of the above-described well as filed and that the same are true and correct. So help me God.

(Signature) George E. Miller, Jr.
Box 1413 Great Bend, KS 67530
(Address)

SUBSCRIBED AND SWORN TO before me this 5th day of June, 19 84

Helen C. Standley
Helen C. Standley Notary Public.

My commission expires 12-8-87

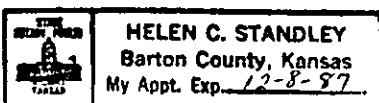

RECEIVED
STATE CORPORATION COMMISSION

JUN 14 1984
06-14-1984
CONSERVATION DIVISION
Wichita, Kansas