


WELL PLUGGING RECORD

Give All Information Completely
Make Required Affidavit
Mail or Deliver Report to:
Conservation Division
State Corporation Commission
211 No. Broadway
Wichita, Kansas

NORTH

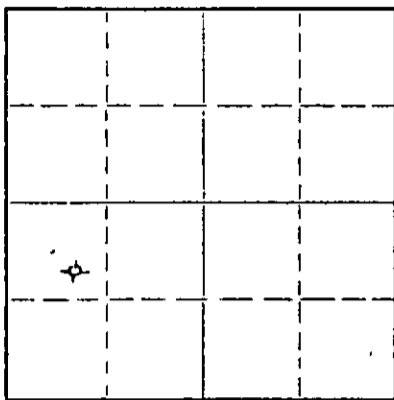

Locate well correctly on above Section Plat

Ness County. Sec. 3 Twp. 16S Rge. 21 (E) W (W)
Location as "NE/CNW/SW" or footage from lines SE/4 NW/4 SW/4
Lease Owner Birmingham-Bartlett Drilling Co.
Lease Name Elmore Well No. 1
Office Address 300 Kaufman Building, Wichita 2, Kansas
Character of Well (completed as Oil, Gas or Dry Hole) Dry Hole
Date well completed September 2, 1957
Application for plugging filed (verbal) September 2, 1957
Application for plugging approved (verbal) September 2, 1957
Plugging commenced September 2, 1957
Plugging completed September 2, 1957
Reason for abandonment of well or producing formation Dry Hole

If a producing well is abandoned, date of last production _____ 19____
Was permission obtained from the Conservation Division or its agents before plugging was commenced? Yes

Name of Conservation Agent who supervised plugging of this well ELSON PECK R. M. Brundage
Producing formation _____ Depth to top _____ Bottom _____ Total Depth of Well 4315 Feet
Show depth and thickness of all water, oil and gas formations.

OIL, GAS OR WATER RECORDS

CASING RECORD

FORMATION	CONTENT	FROM	TO	SIZE	PUT IN	PULLED OUT
		0	285'	8-5/8"	285'	none

Describe in detail the manner in which the well was plugged, indicating where the mud fluid was placed and the method or methods used in introducing it into the hole. If cement or other plugs were used, state the character of same and depth placed, from _____ feet to _____ feet for each plug set.

25 sacks cement mixed and spotted through drill pipe at 600'. 25 sacks mixed and pumped through drill pipe on plug set at 270' 10 sacks mixed and poured on plug set at 45'.

STATE OF KANSAS
OCT 9 1957

(If additional description is necessary, use BACK of this sheet)
Name of Plugging Contractor Birmingham-Bartlett Drilling Co.
Address 300 Kaufman Bldg., Wichita 2, Kansas

STATE OF Kansas COUNTY OF Sedgwick
Richard Hindery, partner of Birmingham-Bartlett Drilling Co., owner, operator and contractor
well, being first duly sworn on oath, says: That I have knowledge of the facts, statements, and matters herein contained and the log of the above-described well as filed and that the same are true and correct. So help me God. BIRMINGHAM-BARTLETT DRILLING CO.
(Signature) By Richard Hindery Partner
300 Kaufman Bldg., Wichita 2, Kansas
(Address)

SUBSCRIBED AND SWORN to before me this 4th day of September, 19 57.

Beverly Larson
Notary Public.

My commission expires October 2, 1958.

PLUGGING
FILE SEC 3 T 16 R 21W
BOOK PAGE 42 LINE 23

15-135-00123-00-00

ELMORE NO. 1 WELL

LOCATION: SE/4 NW/4 SW/4
Section 3-16S-21W
Ness County, Kansas

SPUDDED: 8-19-57
COMPLETED: 9-2-57

OWNER, OPERATOR
and CONTRACTOR: Birmingham-Bartlett Drilling Co.
300 Kaufman Building
Wichita 2, Kansas

SURFACE CASING: 8-5/8" 2 1/2" casing cemented at 235'
with 175 sacks cement and 4 c.c.

OIL STRING: None set. Dry and abandoned.
Plugged 9-2-57.

LOG

(Figures indicate bottom of formation)

0 - 150	Lime and shale
1050	Shale
1360	Sand and shale
1385	Shale
1666	Shale and red bed
1700	Anhydrite
2330	Shale and shells
2360	Shale
3697	Lime and shale
4140	Lime
4158	Cherty lime
4217	Lime
4253	Sand
4259	Lime, shale and sand
4315	Lime
4315	Rotary total depth

The undersigned, Richard Hindery, one of the partners of Birmingham-Bartlett Drilling Co., hereby certifies that the above is a true and correct log of the formations encountered in drilling the Elmore No. 1 Well as shown in the daily drilling reports.

BIRMINGHAM-BARTLETT DRILLING CO.

By Richard Hindery

Subscribed and sworn to before me this
4th day of September, 1957.

Beverly Larson
Notary Public

My commission expires October 2, 1958.

PLUGGING
FILE SEC 3 T 16 R 21W
LOOK PAGE 42 LINE 23

09-05-1957
SEP 5 1957