

CARD MUST BE TYPED

CORRECTED State of Kansas

CARD MUST BE SIGNED

NOTICE OF INTENTION TO DRILL

(see rules on reverse side)

Collection
10-23-86

Starting Date October 30, 1986
month day year

API Number 15- 169-20,292-00-00

OPERATOR: License # 5501

32'E of NW SE SE Sec. 33 Twp. 16 S. Rg. 3W X East

Name .. Raymond M. Goodin Trust

990' Ft. from South Line of Section

Address 333 E. English Suite 280

X 958' Ft. from East Line of Section

City/State/Zip Wichita, Kansas 67202

(Note: Locate well on Section Plat on reverse side)

Contact Person.... Raymond M. Goodin

Nearest lease or unit boundary line 330 feet

Phone 316/262-2192

County..... Saline

CONTRACTOR: License # 5302

Lease Name... Morris "A" Well # 1

Name Red Tiger Drilling Company

Ground surface elevation feet MSL

City/State..... Wichita, Kansas 67202

Domestic well within 330 feet: _____ yes X no

Well Drilled For: Well Class: Type Equipment:

Municipal well within one mile: _____ yes X no

Oil SWD Infield Mud Rotary

Depth to bottom of fresh water 60

Gas Inj Pool Ext. Air Rotary

Depth to bottom of usable water 200

OWWO Expl Wildcat Cable

Surface pipe by Alternate: 1 X 2

If OWWO: old well info as follows:

Surface pipe planned to be set 385

Operator

Conductor pipe required 138

Well Name

Projected Total Depth 3500 feet

Comp Date..... Old Total Depth.....

Formation..... Simpson Sand

I certify that well will comply with K.S.A. 55-101, et seq., plus eventually plugging hole to KCC specifications.

Date ... 10-23-86 ... Signature of Operator or Agent (Raymond M. Goodin)

Title..... Geologist

For KCC Use:

Conductor Pipe Required 130 feet; Minimum Surface Pipe Required 200 feet per Alt. 1 & 4

This Authorization Expires 4-22-87 Approved By 10-22-86

990' 990' FA


CORRECTED (MOVED 32' EAST AT REQUEST OF PIPELINE COMPANY)

Must be filed with the K.C.C. five (5) days prior to commencing well
This card void if drilling not started within six (6) months of date received by K.C.C.

Important procedures to follow:

1. Notify District office before setting surface casing.
2. Set surface casing by circulating cement to the top.
3. File completion forms ACO-1 with K.C.C. within 90 days of well completion, following instructions on ACO-1, side 1, and including copies of wireline logs.
4. Notify District office 48 hours prior to old well workover or re-entry.
5. Prior to filing Intent, prepare a proposed plugging plan in case well is D & A, then obtain approval of plan when calling district office prior to setting surface pipe.
6. Submit plugging report (CP-4) to K.C.C. after plugging is completed.
7. Obtain an approved injection docket number before disposing of salt water.
8. Notify K.C.C. within 10 days when injection commences or terminates.
9. If an alternate 2 completion, cement in the production pipe from below any usable water to surface within 120 days of spud date.

A Regular Section of Land
1 Mile = 5,280 Ft.

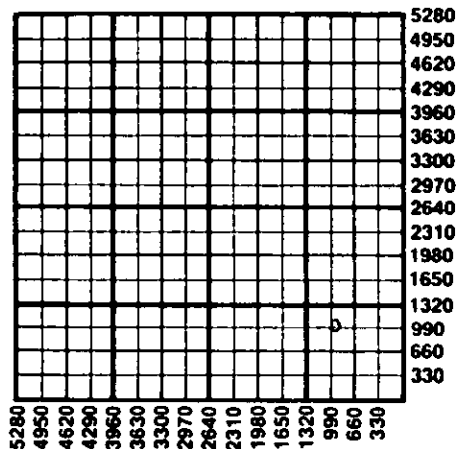

RWD
10-22-86

State Corporation Commission of Kansas
Conservation Division
200 Colorado Derby Building
Wichita, Kansas 67202
(316) 263-3238