


15-185-21803-0000

WELL PLUGGING RECORD

Give All Information Completely
 Make Required Affidavit

COUNTY Stafford SEC. 15 TWP. 25 RGE. 14 E/W
 Location as in quarters or footage from lines:
 SW SE ~~NE~~ NE from 4-20-201

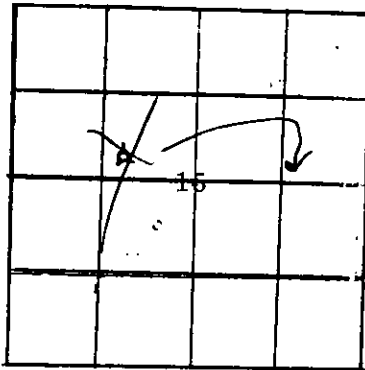

Locate Well
 correctly on above
 Section Platt.

Lease Owner J. A. Allison
 Lease Name Fox Well No. 1
 Office Address 300 W. Douglas, Wichita, Ks. 67202
 Character of Well (Completed as Oil, Gas or Dry Hole): Dry Hole
 Date Well Completed 7-03-83
 Application for plugging filed 7-03-83
 Plugging commenced 7-03-83
 Plugging completed 7-03-83

Reason for abandonment of well or producing formation
Dry Hole

Was permission obtained from the Conservation Division or it's
 Agent's before plugging was commenced? Yes

Name of Conservation Agent who supervised plugging of this well J. H. Metz
 Producing formation _____ Depth to top _____ bottom _____ T.D. 4295

Show depth and thickness of all water, oil and gas formations.

OIL, GAS OR WATER RECORDS

Casing Record

Formation	Content	From	To	Size	Put in	Pulled Out
		Surface	370	8 5/8		

Describe in detail the manner in which the well was plugged, indicating where the mud
 fluid was placed and the method or methods used in introducing it into the hold. If cement
 or other plugs were used, state the character of same and depth placed, from _____ feet
 to _____ feet for each plug set.

- 60 sacks cement at 900'
- 50 sacks cement at 360'
- 10 sacks cement at 40'
- 10 sacks cement in rat hole
- 5 sacks cement in water well
- Job complete 8:45 A.M. 7-30-83

(If additional description is necessary, use BACK of this sheet)

Name of Plugging Contractor Zenith Drilling Corporation

STATE OF KANSAS COUNTY OF SEDGWICK, ss.
Emmet E. Hall (employee of owner) or (owner or operator) of the
 above-described well, being first duly sworn on oath, says: That I have knowledge of the
 facts, statements, and matters herein contained and the log of the above-described well as
 filed and that the same are true and correct. So help me God.
 (Signature) Emmet E. Hall
505-4th Financial Ctr., Wichita, Ks.
 (Address)

SUBSCRIBED AND SWORN TO before me this 13th day of July, 1983

Sharon R. Allen
 Sharon R. Allen Notary Public.

My Commission expires: Dec. 15, 1984

RECEIVED
 STATE CORPORATION COMMISSION

JUL 15 1983

CONSERVATION DIVISION
 Wichita, Kansas

APR 14 1983

15-185-21803-0000

WELL LOG

COMPANY J. A. Allison

SEC. 15-25-14W

FARM FOX

NO. 1

LOC. SW SE NE


TOTAL DEPTH 4295

COUNTY Stafford

COMM. 6-20-83

COMP. 7-02-83

CONTRACTOR Zenith Drilling Corporation

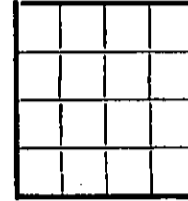

CASING

Ran 9 jts. new, 20#, 8 5/8" casing, set at 370' with 325 sacks cement

ELEVATION

PRODUCTION

FIGURES INDICATE BOTTOM OF FORMATIONS

374	Sand & Red Bed
1780	Red Bed
4295	Lime & Shale

PLUGGING INFORMATION

60 sacks cement at 900'
 50 sacks cement at 360'
 10 sacks cement at 40'
 10 sacks cement in rat hole
 5 sacks cement in water well

JOB COMPLETE 8:45 A.M. JULY 3, 1983

State of KANSAS }
 County of SEDGWICK } ss

I, Emmet E. Hall of Zenith Drilling Corporation

upon oath state the above and foregoing is a true and correct copy of the log of the Fox #1 well.

Subscribed and sworn to before me this 8th day of July, 1983.

My Commission Expires: Dec. 15, 1984

Sharon R. Allen NOTARY PUBLIC

RECEIVED
STATE CORPORATION COMMISSION

JUL 15 1983

CONSERVATION DIVISION
Wichita, Kansas