

STATE OF KANSAS
STATE CORPORATION COMMISSION

WELL PLUGGING RECORD

Give All Information Completely
Make Required Affidavit
Mail or Deliver Report to:
Conservation Division
State Corporation Commission
P. O. Box 17027
Wichita, Kansas 67217
NORTH

Lane _____ County. Sec. 9 Twp. 19S Rge. 28W (E) _____ (W) _____
Location as "NE/CNW/SE/SW" or footage from lines C SE NE

Lease Owner Donald C. Slawson

Lease Name Royalty Well No. A-1

Office Address 408 One Twenty Bldg., Wichita, Kansas 67202

Character of Well (completed as Oil, Gas or Dry Hole) oil

Date well completed 7-3- 19 74

Application for plugging filed 10-18- 19 74

Application for plugging approved 10-22- 19 74


Plugging commenced 10-28- 19 74

Plugging completed 11-2 19 74

Reason for abandonment of well or producing formation Not productive

If a producing well is abandoned, date of last production 10-1- 19 74

Was permission obtained from the Conservation Division or its agents before plugging was commenced? Yes

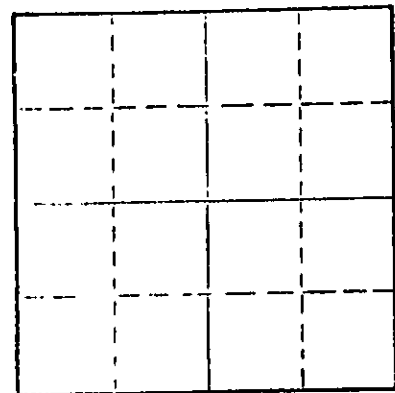

Locate well correctly on above Section Plat

Name of Conservation Agent who supervised plugging of this well W.L. Nichols

Producing formation Miss. Depth to top _____ Bottom _____ Total Depth of Well 4660 Feet

Show depth and thickness of all water, oil and gas formations.

OIL, GAS OR WATER RECORDS

CASING RECORD

FORMATION	CONTENT	FROM	TO	SIZE	PUT IN	PULLED OUT
				8 5/8	249	None
				4 1/2	4325	3202

Describe in detail the manner in which the well was plugged, indicating where the mud fluid was placed and the method or methods used in introducing it into the hole. If cement or other plugs were used, state the character of same and depth placed, from _____ feet to _____ feet for each plug set.

Dump sand from 4285 to 4200'

4 sacks cement from 4200 to 4160'

Ripped at 3500 and 3214'

Pumped in 5 sacks of cotton seed hulls.

25 sacks of jell.

100 sacks 50-50 Pox. with 6% jell.

Cement to surface.

RECEIVED
STATE CORPORATION COMMISSION

NOV 11 1974
11-11-74
CONSERVATION DIVISION
Wichita, Kansas


(If additional description is necessary, use BACK of this sheet)
Name of Plugging Contractor Clarke Corporation 583
Address Box 187, Medicine Lodge, Kansas 67104

STATE OF Kansas COUNTY OF Barker, ss.
Elmer R. Margueter (employee of owner) or (owner or operator) of the above-described well, being first duly sworn on oath, says: That I have knowledge of the facts, statements, and matters herein contained and the log of the above-described well as filed and that the same are true and correct. So help me God.

(Signature) Elmer R. Margueter
Medicine Lodge, Kansas 67104
(Address)

SWORN TO before me this 7th day of November, 1974

Jessie Hamilton
Notary Public.

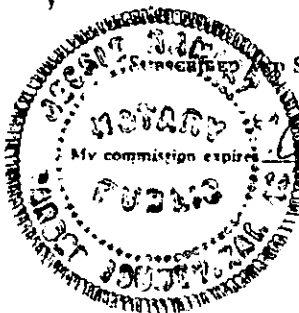

WELL LOG

15101201070000

COMPANY: Donald C. Slawson
 408 One Twenty Building
 Wichita, Kansas 67202

LEASE: Royalty 'A' #1
 C SE NE Sec. 9-19-28W
 Lane County, Kansas

TOTAL DEPTH: 4660 feet

COMMENCED: June 13, 1974

COMPLETED: June 25, 1974

CONTRACTOR: Slawson Drilling Company, Inc.

CASING: Set 8 5/8" @ 242 feet w/200 sx
 42-4325-150 SX

0-1249	Shale & Shells
1249-1917	Shale
1917-2092	Shale & Shells
2092-2124	Anhydrite
2124-2583	Shale & Lime
2583-2665	Lime
2665-3960	Lime & Shale
3960-4622	Lime
4622-4660	Miss
4660	RTD

RECEIVED
 STATE CORPORATION COMMISSION
 OCT 21 1974
 CONSERVATION DIVISION
 Wichita, Kansas

STATE OF KANSAS)
) SS.
 COUNTY OF SEDGWICK)

I, JAMES C. REMSBERG, of the Slawson Drilling Company, Inc. upon oath state that the above and foregoing is a true and correct copy of the log of the Royalty 'A' #1 well.

James C. Remsberg
 James C. Remsberg

Subscribed and sworn to before me this 10th day of July, 1974.

Dolores B. Coady
 Dolores B. Coady, Notary Public

My Commission Expires:

DOLORES B. COADY
 STATE NOTARY PUBLIC
 SEDGWICK COUNTY, KANSAS
 Comm. Exp. 7-1-1975