


STATE OF KANSAS  
STATE CORPORATION COMMISSION  
200 Colorado Derby Bldg.  
Wichita, Kansas 67202

Form CP-4  
Rev. 12-15-8

WELL PLUGGING RECORD

Give All Information Completely  
Make Required Affidavit

COUNTY Lane SEC. 20 TWP. 19S RGE. 28W E/W  
Location as in quarters or footage from lines:  
SW NW SE

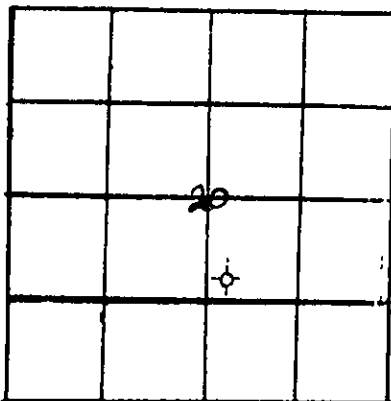

Locate Well  
correctly on above  
Section Platt.

Lease Owner Chief Drilling Co., Inc.  
Lease Name HINEMAN Well No. #1  
Office Address 905 Century Plaza, Wichita, Ks. 67202  
Character of Well (Completed as Oil, Gas or Dry Hole): D.H.  
Date Well Completed 1-12-84  
Application for plugging filed 1-12-84  
Plugging commenced 1-12-84  
Plugging completed 1-12-84  
Reason for abandonment of well or producing formation \_\_\_\_\_

Was permission obtained from the Conservation Division or it's  
Agent's before plugging was commenced? yes

Name of Conservation Agent who supervised plugging of this well Bob Tarbutton

Producing formation \_\_\_\_\_ Depth to top \_\_\_\_\_ bottom \_\_\_\_\_ T.D. 4693'

Show depth and thickness of all water, oil and gas formations.

OIL, GAS OR WATER RECORDS

Casing Record

Formation	Content	From	To	Size	Put in	Pulled Out
surface	322' new	8 5/8" casing		20# set	@ 325' cem	w/190 sx
	60-40 pos	mix, 3% c c		2# gel		

Describe in detail the manner in which the well was plugged, indicating where the mud fluid was placed and the method or methods used in introducing it into the hold. If cement or other plugs were used, state the character of same and depth placed, from \_\_\_\_\_ feet to \_\_\_\_\_ feet for each plug set.

Plugged w/215 sx. 60-40 pos mix, 2# gel, 3% c.c. 1st plug @ 2130'  
w/50 sx., 2nd plug @ 1620' w/50 sx., 3rd plug @ 1020' w/50 sx.,  
4th plug @ 360' w/40 sx., solid bridge plug 0 - 40' w/10 sx.,  
15 sx., in the rat hole, Bob Tarbutton, state pluggger, started  
@ 1:30 p.m., completed @ 3:45 p.m.

(If additional description is necessary, use BACK of this sheet)

Name of Plugging Contractor Warrior Drilling Co.,

STATE OF Kansas COUNTY OF Lane, ss.

F.W. Shelton, Jr., (employee of owner) ~~xxx(OWNER OR OPERATOR)~~ of the above-described well, being first duly sworn on oath, says: That I have knowledge of the facts, statements, and matters herein contained and the log of the above-described well as filed and that the same **RECEIVED** and correct. So help me God.

STATE CORPORATION COMMISSION

(Signature) F.W. Shelton, Jr.  
F.W. Shelton, Jr., Vice Pres.

(Address)

905 Century Plaza, Wichita, Ks.

SUBSCRIBED AND SWORN TO before me this 12 day of Jan., 19 84



Martha E. Gustin  
Notary Public.

My Commission expires \_\_\_\_\_