

This form shall be filed in duplicate with the Kansas Corporation Commission, 200 Colorado Derby Building, Wichita, Kansas 67202, within ten days after the completion of the well, regardless of how the well was completed.

Attach separate letter of request if the information is to be held confidential. If Confidential, only file one copy. Information on side one will be of public record and side two will then be held confidential.

Circle one: Oil, Gas, Dry, SWD, OWWO, Injection. Type and complete ALL sections. Applications must be filed for dual completion, commingling, SWD and injection.

Attach wireline logs (i.e. electrical log, sonic log, gamma ray neutron log, etc.). KCC # (316) 263-3238. (Rules 82-2-105 & 82-2-125)

OPERATOR DONALD C. SLAWSON

API NO. 15-135-22,167-00-00

ADDRESS 200 Douglas Building

COUNTY Ness

Wichita, Kansas 67202

FIELD

\*\*CONTACT PERSON Sherry Kendall

PROD. FORMATION NA

PHONE 316-263-3201

LEASE SCHWEITZER 'C'

PURCHASER NA

WELL NO. 1

ADDRESS

WELL LOCATION C NW NE

DRILLING SLAWSON DRILLING CO., INC.

680 Ft. from north Line and

CONTRACTOR

1990 Ft. from east Line of

ADDRESS 200 Douglas Building

the NE/C SEC. 22 TWP. 16 RGE. 24 West


Wichita, Kansas 67202

WELL FLAT

PLUGGING Allied Cementing Co., Inc.

CONTRACTOR

ADDRESS Box 31

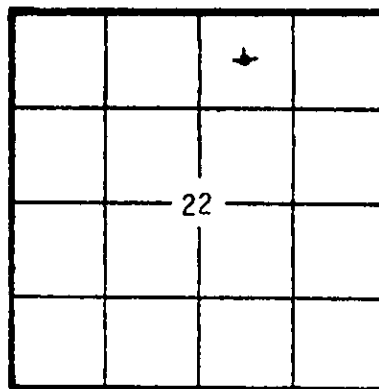

KCC ✓  
KGS ✓  
(Office Use)

Russell, Kansas 67665

TOTAL DEPTH 4580' PBD NA

SPUD DATE 11/6/81 DATE COMPLETED 11/16/81

ELEV: GR 2504 DF 2507 KB 2510

DRILLED WITH (KANKER) (ROTARY) (WDR) TOOLS

Amount of surface pipe set and cemented 287' DV Tool Used? no

AFFIDAVIT

STATE OF KANSAS, COUNTY OF SEDGWICK SS, I,

William R. Horigan OF LAWFUL AGE, BEING FIRST DULY SWORN UPON HIS OATH,

DEPOSES THAT HE IS Operations Engineer (FOR)(OF) Donald C. Slawson

OPERATOR OF THE Schweitzer 'C' LEASE, AND IS DULY AUTHORIZED TO MAKE

THIS AFFIDAVIT FOR AND ON THE BEHALF OF SAID OPERATOR, THAT WELL NO. 1 ON


SAID LEASE HAS BEEN COMPLETED AS OF THE 16th DAY OF November, 19 81, AND THAT

ALL INFORMATION ENTERED HEREIN WITH RESPECT TO SAID WELL IS TRUE AND CORRECT.

FURTHER AFFIANT SAITH NOT.

(s) William R. Horigan  
William R. Horigan

SUBSCRIBED AND SWORN BEFORE ME THIS 11th DAY OF January 19 82

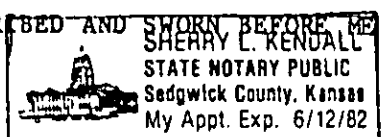

Sherry L. Kendall  
NOTARY PUBLIC  
Sherry L. Kendall

MY COMMISSION EXPIRES: 06/12/82

RECEIVED

\*\*The person who can be reached by phone regarding any questions concerning this information. Within 45 days of completion, a witnessed initial test by the Commission is required if the well produces more than 25 BOPD or is located in a Basic Order

STATE CORPORATION COMMISSION  
JAN 19 1982  
01-19-1982  
CONSERVATION DIVISION  
Wichita, Kansas