

1 070749

11-2

To: STATE CORPORATION COMMISSION
CONSERVATION DIVISION - PLUGGING SECTION
200 COLORADO DERBY BUILDING
WICHITA, KANSAS 67202

API NUMBER 15- 135-23,394 -00-00
SE SW SE, SEC. 30, T 16 S, R 24 W/E

330 feet from S section line
1650 feet from E section line

TECHNICIAN'S PLUGGING REPORT

Operator License # 5215

Lease Name Giess Well # 1

Operator: Lee Phillips Oil Company
Name & Address: 125 North Market, Suite 1532
Wichita, KS 67202

County Ness 149.50

Well Total Depth 4600 feet

Conductor Pipe: Size _____ feet

Surface Casing: Size 8 5/8 feet 314

Abandoned Oil Well _____ Gas Well _____ Input Well _____ SWD Well _____ D&A X

Other well as hereinafter indicated _____

Plugging Contractor Mallard J.V. Inc. License Number 4958

Address P.O. Box 1009, McPherson, KS 67460

Company to plug at: Hour: 1:45 p.m. Day: 2 Month: 11 Year: 19 89

Plugging proposal received from Arnie Hess

(company name) Mallard J.V. Inc. (phone) 913-731-2869

were: to fill hole with heavy mud and spot cement through drill pipe Anhydrite 1916-49' Elevation 2242' GL

1st plug at 1950' with 50 sx cement, 2nd plug at 1150' with 80 sx cement,

3rd plug at 345' with 40 sx cement, 4th plug at 40' with 10 sx cement,

5th plug to circulate rathole with 15 sx cement,

6th plug to circulate mousehole with 10 sx cement.

Plugging Proposal Received by Mike Wilson (TECHNICIAN)

Plugging Operations attended by Agent?: All X Part _____ None _____

Operations Completed: Hour: 3:30 p.m. Day: 2 Month: 11 Year: 1989

ACTUAL PLUGGING REPORT 1st plug at 1950' with 50 sx cement,

2nd plug at 1150' with 80 sx cement,

3rd plug at 345' with 40 sx cement,

4th plug at 40' with 10 sx cement,

5th plug to circulate rathole with 15 sx cement,

6th plug to circulate mousehole with 10 sx cement.

Remarks: Used 60/40 Pozmix 6% gel by Halliburton.

(If additional description is necessary, use BACK of this form.)

INVOICED

DATE 11-13-89

Signed Dan Goodrow (TECHNICIAN)

INV. NO. 26388 FEB 09 1990

RECEIVED
STATE CORPORATION COMMISSION
NOV - 17 1989
11-07-1989
CONSERVATION DIVISION
Wichita, Kansas

Must be approved by the K.C.C. five (5) days prior to commencing well

Expected Spud Date October 19 1989
month day year

SE. SW. SE. Sec. 30 Twp. 16 S, Rg. 24 East
 West

OPERATOR: License # 5215
Name: Lee Phillips Oil Company
Address: 125 N. Market Suite 1532
City/State/Zip: Wichita, Kansas 67202
Contact Person: Lee E. Phillips III
Phone: 316-264-6392

330 feet from South line of Section
1650 feet from East line of Section
(Note: Locate well on Section Plat Below)

CONTRACTOR: License #: 4958
Name: Mallard Drilling

County: Ness
Lease Name: Gless Well #: 1
Field Name: (Dubbs) Unknown
Is this a Prorated Field? yes no
Target Formation(s): Mississippian
Nearest lease or unit boundary: 330
Ground Surface Elevation: Unknown feet MSL
Domestic well within 330 feet: yes no
Municipal well within one mile: yes no
Depth to bottom of fresh water: 200
Depth to bottom of usable water: 1050
Surface Pipe by Alternate: 1 2
Length of Surface Pipe Planned to be set: 300
Length of Conductor pipe required: None
Projected Total Depth: 4600
Formation at Total Depth: Mississippian
Water Source for Drilling Operations:
... well ... farm pond ... other

Well Drilled For: Well Class: Type Equipment:
 Oil ... Inj ... Infield Mud Rotary
 Gas ... Storage Pool Ext. ... Air Rotary
 OAWD ... Disposal ... Wildcat ... Cable
 Seismic; ... # of Holes

If OAWD: old well information as follows:
Operator: _____
Well Name: _____
Comp. Date: _____ Old Total Depth _____

Directional, Deviated or Horizontal wellbore? ... yes no
If yes, total depth location: _____

DWR Permit #: _____
Will Cores Be Taken?: ... yes no
If yes, proposed zone: _____

Exp. 4/13/90 *Set 300' of 858 on 10-25-89*
AFFIDAVIT 220' Alt. II Req.

Joanie

PUSHER Wayne Flood
TD 4602 FORMATION Miss
SURFACE PIPE 8 5/8 @ 314'
ANHYDRITE A1650 ELEVATION 2542
1989

STARTING TIME & DATE _____
COMPLETION TIME & DATE _____
1st PLUG @ 1950 FT. W/ 50 SX
2nd PLUG @ 1150 FT. W/ 80 SX
3rd PLUG @ 345 FT. W/ 40 SX
4th PLUG @ 40 FT. W/ 10 SX
RAT HOLE CIRCULATED W/ 15 SX
MOUSE HOLE CIRCULATED W/ 10 SX
WATER WELL PLUGGED W/ _____ SX

CEMENT COMPANY Halliburton
TECHNICIAN Mike Wilson


TYPE OF CEMENT 10/40 Rosemount
W/ 6% log. ad

11-07-1989
RECEIVED
STATE CORPORATION COMMISSION
NOV - 7 1989

CONSERVATION DIVISION
Wichita, Kansas

Good draw

W. H. Hensley
Agent: W. H. Hensley
24w

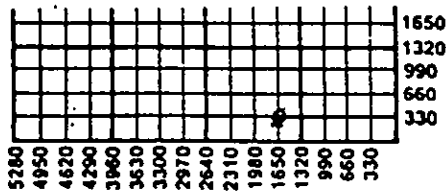

- REMEMBER TO:
- File Drill Pit Application (form CDP-1) with Intent to Drill;
 - File Completion Form ACO-1 within 120 days of spud date;
 - File acreage attribution plat according to field proration orders;
 - Notify appropriate district office 48 hours prior to workover or re-entry;
 - Submit plugging report (CP-4) after plugging is completed;
 - Obtain written approval before disposing or injecting salt water.