

STATE OF KANSAS  
STATE CORPORATION COMMISSION


WELL PLUGGING RECORD

Give All Information Completely  
Make Required Affidavit  
Mail or Deliver Report to:  
Conservation Division  
State Corporation Commission  
211 No. Broadway  
Wichita, Kansas

Ness County, Sec. 28 Twp. 16 Rge. (E) 24 (W)

Location as "NE/CNW/SW" or footage from lines SE SE  
Lease Owner Pickrell Drilling Company  
Lease Name Baer Well No. 3  
Office Address 705 4th National Bank Building, Wichita, Kansas  
Character of Well (completed as Oil, Gas or Dry Hole) Dry Hole  
Date well completed April 12 19 64  
Application for plugging filed April 12 19 64  
Application for plugging approved April 12 19 64  
Plugging commenced April 12 19 64  
Plugging completed April 12 19 64  
Reason for abandonment of well or producing formation Dry Hole

NORTH

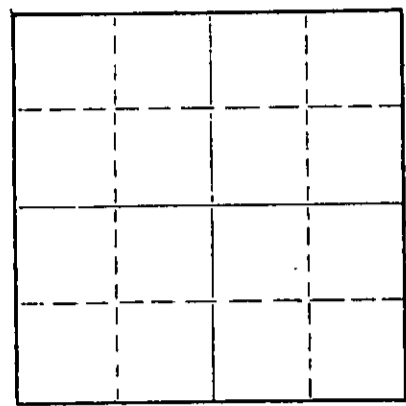

Locate well correctly on above Section Plat

If a producing well is abandoned, date of last production 19  
Was permission obtained from the Conservation Division or its agents before plugging was commenced? Yes

Name of Conservation Agent who supervised plugging of this well Gilbert P. Leiker  
Producing formation Depth to top Bottom Total Depth of Well 4546 Feet  
Show depth and thickness of all water, oil and gas formations.

OIL, GAS OR WATER RECORDS

CASING RECORD

FORMATION	CONTENT	FROM	TO	SIZE	PUT IN	PULLED OUT
				8 5/8"	268'	None

Describe in detail the manner in which the well was plugged, indicating where the mud fluid was placed and the method or methods used in introducing it into the hole. If cement or other plugs were used, state the character of same and depth placed, from feet to feet for each plug set.

Heavy mud to 240'. Set plug. Cemented with  
25 sacks cement. Heavy mud to 40'. Set plug.  
Cemented with 10 sacks cement to bottom of  
cellar. Plugged rat hole with 2 sacks cement.

RECEIVED  
STATE CORPORATION COMMISSION

APR 20 1964

04-20-1964

CONSERVATION DIVISION  
Wichita, Kansas

(If additional description is necessary, use BACK of this sheet)

Name of Plugging Contractor Pickrell Drilling Company  
Address 705 4th National Bank Building, Wichita 2, Kansas

STATE OF KANSAS, COUNTY OF SEDGWICK, ss.

C. W. Sebitts (owner or operator) of the above-described well, being first duly sworn on oath, says: That I have knowledge of the facts, statements, and matters herein contained and the log of the above-described well as filed and that the same are true and correct. So help me God.

(Signature) C. W. Sebitts  
705 4th National Bank Building, Wichita 2, Kansas  
(Address)

SUBSCRIBED AND SWORN to before me this 15th day of April, 19 64

My commission expires June 21, 1966 Maxine Blackman Notary Public.

ROTARY DRILLING LOG

COMPANY: PICKRELL DRILLING COMPANY Rotary Drilling Commenced 3-30-64  
705 4th National Bank Building  
Wichita 2, Kansas Rotary Drilling Completed 4-12-64  
LOCATION: Baer No. 3, SE SE Section 28-16S-24W, Ness County, Kansas

CONTRACTOR: PICKRELL DRILLING COMPANY  
Wichita, Kansas

CASING RECORD: (13 jts) 8 5/8" surface casing set at 268' cemented with 175  
sacks cement. Circulated. Completed 11:00 P.M. March 30, 1964.  
No oil string run. D & A.

LOG

(Figures indicate bottom of formation — measurements from top of rotary bushing.)

70	Sandy Clay	
268	Shale & Shells	<u>C. F. S.</u>
680	Shale	4143
760	Shale & Shells	4426
820	Sand	4440
970	Shale & Shells	4490
1005	Sand	4500
1230	Shale & Shells	4506
1245	Blaine	4513
1325	Red Bed & Shale	4521
1595	Sand	4536
1790	Shale, Shells & Red Bed	4546
1820	Shale & Shells	
1893	Anhydrite	
2515	Lime & Shale	<u>Slope Tests</u>
2975	Lime	2500
3630	Lime & Shale	3000
3685	Sandy, Lime & Shale	3500
3785	Sand, Shale & Lime	4000
3805	Lime & Shale	
3875	Sandy, Shaly Lime	<u>S. L. M.</u>
3920	Lime & Shale	3878
4355	Lime	4127
4506	Lime & Shale	4363
4521	Lime, Shale & Sand	
4546	R.T.D. - Mississippian	

RECEIVED  
STATE CORPORATION COMMISSION  
APR 20 1964  
04-20-1964  
CONSERVATION DIVISION  
Wichita, Kansas

The undersigned, C. W. Sebitts, Attorney-in-Fact for PICKRELL DRILLING COMPANY, hereby certifies in behalf of said Company, that the above is a true and correct log of the formation encountered in drilling the above well as reflected by the Daily Drilling Reports.

PICKRELL DRILLING COMPANY  
By C. W. Sebitts Attorney-in-Fact

STATE OF KANSAS }  
COUNTY OF SEDGWICK } ss.:

On this 15th day of April, 1964, before me the undersigned, a Notary Public, in and for the County and State aforesaid, personally appeared C. W. Sebitts, to me known to be the identical person who subscribed the name of PICKRELL DRILLING COMPANY to the foregoing instrument as its Attorney-in-Fact and acknowledged to me that he executed the same as his free and voluntary act and deed, and as the free and voluntary act and deed of such company, for the uses and purposes therein set forth.

Given under my hand and seal of office the day and year last above written.

My commission expires: June 21, 1966

Maxine Blackman  
Maxine Blackman Notary Public