

STATE CORPORATION COMMISSION OF KANSAS
OIL & GAS CONSERVATION DIVISION

WELL COMPLETION OR RECOMPLETION FORM
ACO-1 WELL HISTORY

DESCRIPTION OF WELL AND LEASE

Operator: License # 6249
Name Zenith Petroleum Corporation
Address 1235 N. Loop W. Suite 919
City/State/Zip Houston, Texas 77008

Purchaser

Operator Contact Person Joe Gibson
Phone 713-863-7741

Contractor: License # 5671
Name Reylin Drlg. Inc. Box 293
Russell, Ks. 67665

Wellsite Geologist
Phone

Designate Type of Completion

New Well Re-Entry Workover

Oil SWD Temp Abd
 Gas Inj Delayed Comp.
 Dry Other (Core, Water Supply etc.)

If ONWO: old well info as follows:

Operator
Well Name
Comp. Date Old Total Depth

WELL HISTORY

Drilling Method:

Mud Rotary Air Rotary Cable

6-28-85 7-5-85 7-6-85
Spud Date Date Reached TD Completion Date

4263
Total Depth PBTD

Amount of Surface Pipe Set and Cemented at 76.1 feet
Multiple Stage Cementing Collar Used? Yes No
If yes, show depth set.....feet
If alternate 2 completion, cement circulated
from.....feet depth to.....w/.....SX cmt

API NO. 15-135-22,853-00-00

County Ness

G.S/2..SW..SW Sec..27. Twp..16. Rge..21. East West

330 Ft North from Southeast Corner of Section
4620 Ft West from Southeast Corner of Section

(Note: Locate well in section plat below)


Lease Name Stevens Well # 1

Field Name

Producing Formation

Elevation: Ground 2357 KB 2263

Section Plat

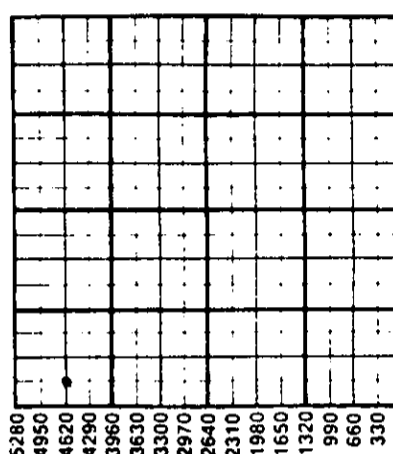

WATER SUPPLY INFORMATION

Disposition of Produced Water: Disposal
Docket # Repressuring

Questions on this portion of the ACO-1 call:
Water Resources Board (913) 296-3717

Source of Water:
Division of Water Resources Permit # N/A

Groundwater.....Ft North from Southeast Corner
(Well)Ft West from Southeast Corner of
Sec Twp Rge East West

Surface Water.....Ft North from Southeast Corner
(Stream, pond etc).....Ft West from Southeast Corner
Sec Twp Rge East West

Other (explain) less than a 15' acre pond
(purchased from city, R.W.D. #)

INSTRUCTIONS: This form shall be completed in duplicate and filed with the Kansas Corporation Commission, 200 Colorado Derby Building, Wichita, Kansas 67202, within 90 days after completion or recompletion of any well. Rule 82-3-130 and 82-3-107 apply.

Information on side two of this form will be held confidential for a period of 12 months if requested in writing and submitted with the form. See rule 82-3-107 for confidentiality in excess of 12 months. One copy of all wireline logs and drillers time log shall be attached with this form. Submit CP-4 form with all plugged wells. Submit CP-111 form with all temporarily abandoned wells.

All requirements of the statutes, rules and regulations promulgated to regulate the oil and gas industry have been fully complied with and the statements herein are complete and correct to the best of my knowledge.

Signature Joseph G. Gibson
Title JOSEPH G. GIBSON, President Date 8/09/85

Subscribed and sworn to before me this 9th day of August 1985
Notary Public Joyelyn Crouch

Date Commission Expires 7/11/87

K.C.C. OFFICE USE ONLY
 Letter of Confidentiality Attached
 Wireline Log Received
 Drillers Timelog Received
Distribution
 KCC SWD/Rep NGPA
 KGS Plug Other
(Specify)
RECEIVED
STATE CORPORATION COMMISSION