



KANSAS CORPORATION COMMISSION 1073098
OIL & GAS CONSERVATION DIVISION

Form ACO-1
June 2009

Form Must Be Typed
Form must be Signed
All blanks must be Filled

CONFIDENTIAL

WELL COMPLETION FORM

WELL HISTORY - DESCRIPTION OF WELL & LEASE

OPERATOR: License # 34192
Name: SandRidge Exploration and Production LLC
Address 1: 123 ROBERT S. KERR AVE
Address 2: _____
City: OKLAHOMA CITY State: OK Zip: 73102 + 6406
Contact Person: Tiffany Golay
Phone: (405) 429-6543
CONTRACTOR: License # 34464
Name: Lariat Services, Inc.
Wellsite Geologist: Tammy Alcorn
Purchaser: _____

Designate Type of Completion:

- New Well Re-Entry Workover
- Oil WSW SWD SIOW
 Gas D&A ENHR SIGW
 OG GSW Temp. Abd.
 CM (Coal Bed Methane)
 Cathodic Other (Core, Expl., etc.): _____

If Workover/Re-entry: Old Well Info as follows:

Operator: _____
Well Name: _____
Original Comp. Date: _____ Original Total Depth: _____
 Deepening Re-perf. Conv. to ENHR Conv. to SWD
 Conv. to GSW
 Plug Back: _____ Plug Back Total Depth
 Commingled Permit #: _____
 Dual Completion Permit #: _____
 SWD Permit #: _____
 ENHR Permit #: _____
 GSW Permit #: _____

1/17/2012	2/12/2012	2/15/2012
Spud Date or Recompletion Date	Date Reached TD	Completion Date or Recompletion Date

API No. 15 - 15-077-21795-01-00
Spot Description: _____
S2 S2 SE SW Sec. 12 Twp. 35 S. R. 8 East West
200 Feet from North / South Line of Section
1980 Feet from East / West Line of Section
Footages Calculated from Nearest Outside Section Corner:
 NE NW SE SW
County: Harper
Lease Name: Brad Well #: 1-12H
Field Name: _____
Producing Formation: Mississippi
Elevation: Ground: 1283 Kelly Bushing: 1303
Total Depth: 9999 Plug Back Total Depth: _____
Amount of Surface Pipe Set and Cemented at: 795 Feet
Multiple Stage Cementing Collar Used? Yes No
If yes, show depth set: _____ Feet
If Alternate II completion, cement circulated from: _____
feet depth to: _____ w/ _____ sx cmt.

Drilling Fluid Management Plan

(Data must be collected from the Reserve Pit)

Chloride content: 11000 ppm Fluid volume: 7830 bbls
Dewatering method used: Haul Off Pit
Location of fluid disposal if hauled offsite:
Operator Name: Magnet
Lease Name: unknown License #: 99999
Quarter SW Sec. 32 Twp. 28 S. R. 10 East West
County: Alfalfa, OK Permit #: 12-19473

AFFIDAVIT

I am the affiant and I hereby certify that all requirements of the statutes, rules and regulations promulgated to regulate the oil and gas industry have been fully complied with and the statements herein are complete and correct to the best of my knowledge.

Submitted Electronically

KCC Office Use ONLY

- Letter of Confidentiality Received
Date: 05/01/2012
 Confidential Release Date: _____
 Wireline Log Received
 Geologist Report Received
 UIC Distribution
ALT I II III Approved by: NAOMI JAMES Date: 05/02/2012

	Measured Depth (ft)	Sub-Sea Incl. (ft)	Vertical Azim. (ft)	True Vert Depth (ft)	Northings (+) Southings (-) (ft)	Eastings (+) Westings (-) (ft)	DLS deg/100' (deg)	FNL	FSL	FWL	FEL
	SHL	0	0.00	0.00	0.00	0.00	0.00	0.00	7928.00	-5328.00	1980.00
BHL	11754	91.80	0.50	4784.43	7293.10	-92.23	0.00	634.90	1965.10	1887.77	760.23
Miss Entry	5014	55.28	1.93	4807.93	577.84	43.55	8.08	7350.16	-4750.16	2023.55	624.45
Top Perf	5080	61.61	2.22	4842.57	633.90	45.76	10.63	7294.10	-4694.10	2025.76	622.24
Bottom Perf	11650	91.58	158.40	4787.49	7189.15	-92.93	0.68	736.85	1861.15	1887.07	760.93

	Measured Depth (ft)	Sub-Sea Incl. (ft)	Vertical Azim. (ft)	True Vert Depth (ft)	Northings (+) Southings (-) (ft)	Eastings (+) Westings (-) (ft)	DLS deg/100' (deg)	FNL	FSL	FWL	FEL
		0	0.0	0	0	0	0	0	7928.00	-5328.00	1980.00
	1427	1.70	314.63	1426.79	14.87	-15.06	0.12	7913.13	-5313.13	1964.94	683.06
	1905	1.30	327.70	1904.63	24.44	-23.01	0.11	7903.56	-5303.56	1956.99	691.01
	2860	0.80	335.75	2859.46	39.67	-31.54	0.05	7888.33	-5288.33	1948.46	699.54
	3339	0.80	2.19	3338.43	45.23	-32.81	0.08	7882.77	-5282.77	1947.19	700.81
	3817	0.20	68.88	3816.42	48.03	-31.94	0.12	7879.97	-5279.97	1948.06	699.94
	4041	3.30	27.62	4040.29	53.88	-28.58	1.41	7874.12	-5274.12	1951.42	696.58
	4073	5.50	22.06	4072.19	56.12	-27.58	7.00	7871.88	-5271.88	1952.42	695.58
	4105	7.90	21.43	4103.97	59.59	-26.20	7.50	7868.41	-5268.41	1953.80	694.20
	4137	10.30	22.83	4135.57	64.27	-24.29	7.53	7863.73	-5263.73	1955.71	692.29
	4169	12.60	22.93	4166.93	70.13	-21.82	7.19	7857.87	-5257.87	1958.18	689.82
	4201	14.10	22.40	4198.06	76.94	-18.97	4.70	7851.06	-5251.06	1961.03	686.97
	4233	16.60	22.96	4228.92	84.76	-15.70	7.83	7843.24	-5243.24	1964.30	683.70
	4265	18.90	24.60	4259.39	93.68	-11.76	7.35	7834.32	-5234.32	1968.24	679.76
	4297	21.10	24.60	4289.46	103.63	-7.21	6.88	7824.37	-5224.37	1972.79	675.21
	4329	23.90	23.49	4319.02	114.82	-2.22	8.85	7813.18	-5213.18	1977.78	670.22
	4361	26.50	21.80	4347.98	127.39	3.01	8.43	7800.61	-5200.61	1983.01	664.99
	4393	28.80	19.92	4376.32	141.27	8.29	7.69	7786.73	-5186.73	1988.29	659.71
	4425	31.80	18.15	4403.95	156.53	13.54	9.78	7771.47	-5171.47	1993.54	654.46
	4457	34.60	16.48	4430.72	173.26	18.75	9.20	7754.74	-5154.74	1998.75	649.25
	4489	37.10	14.44	4456.66	191.32	23.73	8.66	7736.68	-5136.68	2003.73	644.27
	4521	39.80	12.98	4481.72	210.65	28.44	8.90	7717.35	-5117.35	2008.44	639.56
	4553	42.00	11.57	4505.90	231.12	32.89	7.46	7696.88	-5096.88	2012.89	635.11
	4585	44.00	9.99	4529.30	252.56	38.97	7.10	7675.44	-5075.44	2016.97	631.03
	4617	45.60	6.68	4552.01	274.87	40.23	8.84	7653.13	-5053.13	2020.23	627.77
	4649	45.60	2.97	4574.41	297.64	42.15	8.28	7630.36	-5030.36	2022.15	625.85
	4680	46.80	1.40	4595.86	320.00	43.00	5.32	7608.00	-5008.00	2023.00	625.00
	4713	49.00	1.25	4617.99	344.47	43.56	6.68	7583.53	-4983.53	2023.56	624.44
	4776	50.80	359.96	4658.56	392.66	44.06	3.26	7535.34	-4935.34	2024.06	623.94
	4821	50.70	359.50	4687.04	427.50	43.90	0.82	7500.50	-4900.50	2023.90	624.10
	4872	50.40	359.24	4719.44	466.88	43.47	0.71	7461.12	-4861.12	2023.47	624.53
	4936	49.80	359.22	4760.50	515.98	42.81	0.94	7412.02	-4812.02	2022.81	625.19
	4968	51.80	0.30	4780.72	540.77	42.71	6.78	7387.23	-4787.23	2022.71	625.29
	5000	54.20	1.67	4799.98	566.32	43.15	8.24	7361.68	-4761.68	2023.15	624.85
	5031	56.60	2.24	4817.58	591.82	44.02	7.89	7336.18	-4736.18	2024.02	623.98
	5063	59.70	2.61	4834.46	618.98	45.18	9.74	7309.02	-4709.02	2025.18	622.82
	5095	63.30	1.88	4849.73	647.07	46.27	11.43	7280.93	-4680.93	2026.27	621.73
	5127	67.40	1.84	4863.07	676.14	47.17	12.83	7251.86	-4651.86	2027.17	620.83
	5159	70.80	1.06	4874.49	706.02	47.87	10.76	7221.98	-4621.98	2027.87	620.13
	5191	74.20	358.23	4884.11	736.53	47.67	13.56	7191.47	-4591.47	2027.67	620.33
	5222	78.40	358.20	4891.45	766.63	46.73	13.55	7161.37	-4561.37	2026.73	621.27
	5263	82.30	358.65	4898.32	807.02	45.62	9.57	7120.98	-4520.98	2025.62	622.38
	5293	86.10	358.45	4901.35	836.85	44.87	12.68	7091.15	-4491.15	2024.87	623.13
	5323	89.30	359.07	4902.56	866.82	44.22	10.86	7061.18	-4461.18	2024.22	623.78
	5353	90.80	359.90	4902.53	896.82	43.95	5.71	7031.18	-4431.18	2023.95	624.05
	5386	91.90	359.80	4901.75	929.81	43.86	3.35	6998.19	-4398.19	2023.86	624.14
	5417	92.30	359.80	4900.62	960.79	43.78	1.29	6967.21	-4367.21	2023.76	624.24
	5449	92.40	359.01	4899.31	992.76	43.42	2.49	6935.24	-4335.24	2023.42	624.58
	5545	92.00	358.24	4895.62	1088.66	41.12	0.90	6839.34	-4239.34	2021.12	626.88
	5642	92.10	358.80	4892.15	1185.56	38.82	0.59	6742.44	-4142.44	2018.62	629.38
	5737	92.30	358.36	4888.50	1280.46	36.27	0.51	6647.54	-4047.54	2016.27	631.73
	5834	92.20	358.42	4884.69	1377.35	33.54	0.12	6550.65	-3950.65	2013.54	634.46
	5930	91.50	358.66	4881.60	1473.27	31.10	0.77	6454.73	-3854.73	2011.10	636.90
	6122	91.80	358.33	4876.07	1665.12	26.06	0.23	6262.88	-3662.88	2006.06	641.94
	6217	91.80	358.75	4873.08	1760.04	23.64	0.44	6167.96	-3567.96	2003.64	644.36
	6312	91.80	359.04	4870.10	1854.98	21.81	0.31	6073.02	-3473.02	2001.81	646.19
	6408	91.00	357.84	4867.75	1950.91	19.19	1.50	5977.09	-3377.09	1999.19	648.81
	6503	91.20	357.63	4865.93	2045.82	15.44	0.31	5882.18	-3282.18	1995.44	652.56
	6597	91.80	357.34	4863.47	2139.70	11.32	0.71	5788.30	-3188.30	1991.32	656.68

6693	90.90	357.18	4861.21	2235.56	6.73	0.95	5692.44	-3092.44	1986.73	661.27
6789	91.10	358.19	4859.53	2331.47	2.85	1.07	5596.53	-2996.53	1982.85	665.15
6884	89.50	358.52	4859.03	2428.42	0.13	1.72	5501.58	-2901.58	1980.13	667.87
6981	89.30	359.39	4860.05	2523.40	-1.64	0.92	5404.60	-2804.60	1978.36	669.64
7076	89.60	359.32	4860.96	2618.39	-2.71	0.32	5309.61	-2709.61	1977.29	670.71
7172	90.10	359.39	4861.21	2714.38	-3.79	0.53	5213.62	-2613.62	1976.21	671.79
7268	90.70	358.87	4860.54	2810.37	-5.25	0.83	5117.63	-2517.63	1974.75	673.25
7363	90.50	359.01	4859.55	2905.35	-7.01	0.26	5022.65	-2422.65	1972.99	675.01
7459	90.70	359.20	4858.54	3001.33	-8.51	0.29	4928.67	-2326.67	1971.49	676.51
7554	91.30	359.70	4856.89	3096.31	-9.42	0.82	4831.69	-2231.69	1970.58	677.42
7642	91.90	359.89	4854.43	3184.27	-9.66	0.76	4743.73	-2143.73	1970.34	677.66
7738	91.50	0.63	4851.58	3280.23	-9.14	0.79	4647.77	-2047.77	1970.86	677.14
7830	90.70	1.71	4849.81	3372.19	-7.26	1.46	4555.81	-1955.81	1972.74	675.26
7921	90.40	0.10	4848.94	3463.17	-5.82	1.80	4464.83	-1864.83	1974.18	673.82
8012	90.60	0.66	4848.15	3554.17	-5.22	0.65	4373.83	-1773.83	1974.78	673.22
8105	90.60	359.19	4847.17	3647.16	-5.34	1.58	4280.84	-1680.84	1974.66	673.34
8196	91.10	359.54	4845.82	3738.14	-6.35	0.67	4189.86	-1589.86	1973.65	674.35
8286	91.40	359.94	4843.86	3828.12	-6.76	0.56	4099.88	-1499.88	1973.24	674.76
8378	91.50	359.19	4841.53	3920.09	-7.46	0.82	4007.91	-1407.91	1972.54	675.46
8470	91.30	357.75	4839.28	4012.03	-9.91	1.58	3915.97	-1315.97	1970.09	677.91
8561	91.80	357.87	4836.82	4102.93	-13.39	0.57	3825.07	-1225.07	1966.61	681.39
8653	92.20	357.80	4833.61	4194.80	-16.86	0.44	3733.20	-1133.20	1963.14	684.86
8745	91.10	356.83	4830.96	4286.66	-21.17	1.59	3641.34	-1041.34	1958.83	689.17
8837	91.60	356.64	4828.79	4378.49	-26.41	0.58	3549.51	-949.51	1953.59	694.41
8928	90.80	356.71	4826.89	4469.31	-31.68	0.88	3458.69	-858.69	1948.32	699.68
9020	91.00	356.86	4825.44	4561.16	-36.84	0.27	3366.84	-766.84	1943.16	704.84
9110	89.90	356.74	4824.74	4651.01	-41.87	1.23	3276.99	-676.99	1938.13	709.87
9202	90.10	356.76	4824.74	4742.86	-47.08	0.22	3185.14	-585.14	1932.92	715.08
9294	90.50	356.63	4824.26	4834.71	-52.39	0.46	3093.29	-493.29	1927.61	720.39
9388	90.70	356.11	4823.27	4928.52	-58.34	0.59	2999.48	-399.48	1921.66	726.34
9438	90.60	356.05	4822.70	4978.40	-61.76	0.23	2949.60	-349.60	1918.24	729.76
9578	90.10	357.03	4821.85	5118.14	-70.20	0.79	2809.86	-209.86	1909.80	738.20
9674	90.00	356.03	4821.76	5213.96	-76.02	1.05	2714.04	-114.04	1903.98	744.02
9769	89.50	358.13	4822.18	5308.83	-80.85	2.27	2619.17	-19.17	1899.15	748.85
9865	89.80	357.65	4822.77	5404.76	-84.39	0.59	2523.24	76.76	1895.61	752.39
9961	89.60	358.56	4823.27	5500.71	-87.56	0.97	2427.29	172.71	1892.44	755.56
10056	90.30	358.31	4823.35	5595.67	-90.16	0.78	2332.33	267.67	1889.84	758.16
10151	90.30	359.08	4822.85	5690.64	-92.32	0.81	2237.36	362.64	1887.68	760.32
10247	91.10	359.28	4821.68	5786.63	-93.70	0.86	2141.37	458.63	1886.30	761.70
10343	91.60	0.02	4819.42	5882.60	-94.28	0.93	2045.40	554.60	1885.72	762.28
10440	92.00	359.76	4816.37	5979.55	-94.47	0.49	1948.45	651.55	1885.53	762.47
10536	92.10	0.18	4812.94	6075.49	-94.52	0.45	1852.51	747.49	1885.48	762.52
10631	92.20	359.84	4809.37	6170.42	-94.50	0.37	1757.58	842.42	1885.50	762.50
10727	92.00	359.58	4805.86	6266.35	-94.99	0.34	1661.65	938.35	1885.01	762.99
10823	90.70	0.05	4803.59	6362.32	-95.30	1.44	1565.68	1034.32	1884.70	763.30
10919	90.70	359.80	4802.42	6458.32	-95.42	0.28	1469.68	1130.32	1884.58	763.42
11015	90.90	0.24	4801.08	6554.31	-95.39	0.50	1373.69	1226.31	1884.61	763.39
11111	91.10	0.19	4799.41	6650.29	-95.03	0.21	1277.71	1322.29	1884.97	763.03
11205	91.20	0.40	4797.52	6744.27	-94.54	0.25	1183.73	1416.27	1885.46	762.54
11302	91.80	0.32	4794.98	6841.24	-93.94	0.62	1086.76	1513.24	1886.06	761.94
11494	90.70	0.10	4790.79	7033.19	-93.23	0.58	894.81	1705.19	1886.77	761.23
11590	91.30	359.96	4789.12	7129.17	-93.18	0.64	798.83	1801.17	1886.82	761.18
11697	91.80	0.52	4786.22	7236.13	-92.73	0.70	691.87	1908.13	1887.27	760.73
11716	91.80	0.50	4785.63	7255.12	-92.56	0.11	672.88	1927.12	1887.44	760.56
11754	91.80	0.50	4784.43	7293.10	-92.23	0.00	634.90	1965.10	1887.77	760.23

Section 11
35S 8W

Section 12
35S 8W

BRAD 1-12H



Miss Entry: 5006'
-98.139359 37.006078

Top Perf: 5026'
-98.139359 37.006027

Section 14
35S 8W

Section 13
35S 8W

Section 15
29N 9W

Section 14
29N 9W

1214' FNL

2507' FWL

Bottom Perf: 9052'
-98.138901 36.994997

BHL: 9142'
-98.138896 36.994751



● Actual BH Location

* SandRidge Wells

○ Perf

□ Sections


Actual Bottom-Hole Location of Brad 1-12H
Alfaifa County, Kansas

T&R: 29S 9W

Section: 14, 2507' FWL & 1214' FNL

Long/Lat: -98.138896 36.994751

1 in = 567 ft

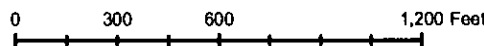

Draftsman:

Aaron Birk

Draft Date: 5/1/2012

Drawing Name/Number:

Addendum_Brad_1-12H.mxd

Coordinate System:

NAD 1927 State Plane
Kansas South FIPS: 1502