

CARD MUST BE TYPED

State of Kansas

CARD MUST BE SIGNED

NOTICE OF INTENTION TO DRILL

(see rules on reverse side)

Starting Date May 3, 1986 month day year

API Number 15- 135-23,026-00-00

OPERATOR: License # 6039
Name L. D. Drilling, Inc.
Address Route 1, Box 183-B
City/State/Zip Great Bend, KS 67530
Contact Person L. D. Davis
Phone 316-793-3051

NE NW SE Sec. 4 Twp. 16 S, Rg. 25 X West
2310
1650 Ft. from South Line of Section
Ft. from East Line of Section

(Note: Locate well on Section Plat on reverse side)

CONTRACTOR: License # 5929
Name Duke Drilling Co., Inc.
City/State Wichita, KS 67202

Nearest lease or unit boundary line 330 feet
County Ness

Lease Name Carter Well # 1

Ground surface elevation 2525' (estimate) feet MSL

Domestic well within 330 feet: yes X no

Municipal well within one mile: yes X no

Depth to bottom of fresh water 100'

Depth to bottom of usable water 1150'

Surface pipe by Alternate: 1 2 X

Surface pipe planned to be set 350'

Conductor pipe required

Projected Total Depth 4525 feet

Formation Miss.

Well Drilled For: Well Class: Type Equipment:
X Oil SWD Infield X Mud Rotary
Gas Inj Pool Ext Air Rotary
OWWO Expl Wildcat Cable

If OWWO: old well info as follows:

Operator
Well Name
Comp Date Old Total Depth

I certify that well will comply with K.S.A. 55-101, et seq., plus eventually plugging hole to KCC specifications.

Date Signature of Operator or Agent J. M. Vess Title

For KCC Use:

Conductor Pipe Required feet; Minimum Surface Pipe Required 200 feet per Alt. X 2

This Authorization Expires 11-2-86 Approved By


Handwritten signature/initials

Must be filed with the K.C.C. five (5) days prior to commencing well
This card void if drilling not started within six (6) months of date received by K.C.C.

Important procedures to follow:

1. Notify District office before setting surface casing.
2. Set surface casing by circulating cement to the top.
3. File completion forms ACO-1 with K.C.C. within 90 days of well completion, following instructions on ACO-1, side 1, and including copies of wireline logs.
4. Notify District office 48 hours prior to old well workover or re-entry.
5. Prior to filing Intent, prepare a proposed plugging plan in case well is D & A, then obtain approval of plan when calling district office prior to setting surface pipe.
6. Submit plugging report (CP-4) to K.C.C. after plugging is completed.
7. Obtain an approved injection docket number before disposing of salt water.
8. Notify K.C.C. within 10 days when injection commences or terminates.

**A Regular Section of Land
1 Mile = 5,280 Ft.**

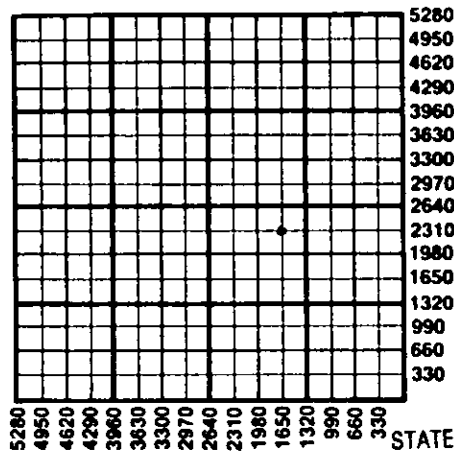

RECEIVED
STATE CORPORATION COMMISSION

MAY 2 - 1986

CONSERVATION DIVISION
Wichita, Kansas

Alternate 2 completion, cement in the production pipe from below any usable water to surface within 120 days of spud date.

State Corporation Commission of Kansas
Conservation Division
200 Colorado Derby Building
Wichita, Kansas 67202
(316) 263-3238