

CARD MUST BE TYPED

State of Kansas

CARD MUST BE SIGNED

NOTICE OF INTENTION TO DRILL

(see rules on reverse side)

Expected Spud Date..... December 10 1987
month day yearAPI Number 15- 135-23,197-00-00
100 East of

OPERATOR: License # 06009

NW SW NW Sec. 2 Twp. 16 S, Rg. 25 East
3630' West
4850' Ft. from South Line of Section
Ft. from East Line of Section

Name Double Eagle Exploration, Inc.

Address 460 Century Plaza Building

City/State/Zip Wichita, Kansas 67202

Contact Person Jim Robinson

Phone 316 267-3316

(Note: Locate well on Section Plat on reverse side)

Nearest lease or unit boundary line 430 feet
County Ness

CONTRACTOR: License # 5146

Lease Name McNinch Well # B 2

Name Rains & Williamson

City/State Wichita, Kansas

Ground surface elevation 2551' feet MSL

Well Drilled For: Well Class: Type Equipment:

Domestic well within 330 feet: —yes noMunicipal well within one mile: —yes no Oil — Storage — Infield Mud Rotary

Depth to bottom of fresh water 200'

 Gas — Inj Pool Ext. — Air Rotary

Depth to bottom of usable water Dakota 1000'

 OWWO — Expl — Wildcat — CableSurface pipe by Alternate: 1 — 2

If OWWO: old well info as follows:

Surface pipe planned to be set 350'

Operator

Conductor pipe required N. R.

Well Name

Projected Total Depth 4550' feet

Comp Date Old Total Depth

Formation Mississippi

I certify that well will comply with K.S.A. 55-101, et seq., plus eventually plugging hole to KCC specifications.

Date 12-7-87 Signature of Operator or Agent Jim Robinson

Title President

For KCC Use:

Conductor Pipe Required feet; Minimum Surface Pipe Required 200 feet per Alt. (2)

This Authorization Expires 6-7-88 Approved By R.H. 12-7-87


EFFECTIVE DATE: 12-12-87

Must be filed with the K.C.C. five (5) days prior to commencing well
This card void if drilling not started within six (6) months of date received by K.C.C.

Important procedures to follow:

1. Notify District office before setting surface casing.
2. Set surface casing by circulating cement to the top.
3. File completion forms ACO-1 with K.C.C. within 120 days of well spud date, following instructions on ACO-1, side 1, and including copies of wireline logs.
4. Notify District office 48 hours prior to old well workover or re-entry.
5. Prior to filing Intent, prepare a proposed plugging plan in case well is D & A, then obtain approval of plan when calling district office prior to setting surface pipe.
6. Submit plugging report (CP-4) to K.C.C. after plugging is completed.
7. Obtain an approved injection docket number before disposing of salt water.
9. If an alternate 2 completion, cement in the production pipe from flow any usable water to surface within 120 days of spud date.

A Regular Section of Land
1 Mile = 5,280 Ft.

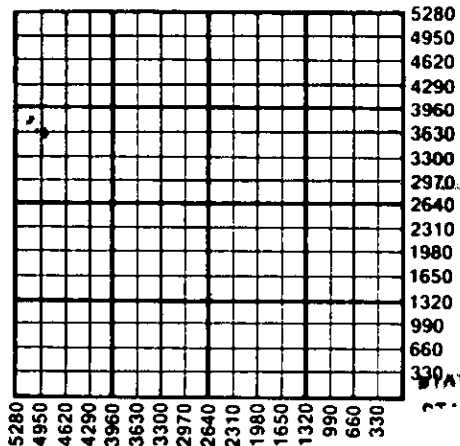

RECEIVED
STATE CORPORATION COMMISSION
DEC 7 1987
12-7-87
CONSERVATION DIVISION
Wichita, Kansas

State Corporation Commission of Kansas
Conservation Division
200 Colorado Derby Building
Wichita, Kansas 67202-1212
(316) 263-3238