

CARD MUST BE TYPED

State of Kansas

CARD MUST BE SIGNED

## NOTICE OF INTENTION TO DRILL

(see rules on reverse side)

Expected Spud Date..... 7..... 3..... 88.....  
month day year

API Number 15-135-23,260-00-00 ✓

OPERATOR: License #..... 06009.....

C. SW. ~~NE~~ Sec. 2 Twp. 16S S. Rg. 25 East  
~~300~~ 3300 West

Name Double Eagle Exploration, Inc.

Address 512 Century Plaza

City/State/Zip Wichita, KS 67202

Contact Person Jim Robinson

Phone 316-267-3316

..... Ft. from South Line of Section

..... Ft. from East Line of Section

(Note: Locate well on Section Plat on reverse side)

Nearest lease or unit boundary line 660 feet

County Ness

CONTRACTOR: License #..... 5146.....

Name Rains &amp; Williamson

City/State Wichita, Kansas

Lease Name Giess Well # 1

Ground surface elevation 2550 feet MSL

Domestic well within 380 feet: yes  noMunicipal well within one mile: yes  no

Well Drilled For: Well Class: Type Equipment:

Depth to bottom of fresh water 200

Depth to bottom of usable water Dakota-1000'

Surface pipe by Alternate: 1 2 

Surface pipe planned to be set 350'

Conductor pipe required NR

Projected Total Depth 4550 feet

Formation Mississippi

If OWWO: old well info as follows:

Operator

Well Name

Comp Date Old Total Depth

I certify that well will comply with K.S.A. 55-101, et seq., plus eventually plugging hole to KCC specifications.

Date 6-23-88 Signature of Operator or Agent Jim Robinson Title President

For KCC Use:

Conductor Pipe Required feet; Minimum Surface Pipe Required 200 feet per Alt.  2

This Authorization Expires 12-23-88 Approved By Feb 6-23-88


EFFECTIVE DATE: 6-28-88

Must be filed with the K.C.C. five (5) days prior to commencing well  
This card void if drilling not started within six (6) months of date received by K.C.C.

**Important procedures to follow:**

1. Notify District office before setting surface casing.
2. Set surface casing by circulating cement to the top.
3. File completion forms ACO-1 with K.C.C. within 120 days of well spud date, following instructions on ACO-1, side 1, and including copies of wireline logs.
4. Notify District office 48 hours prior to old well workover or re-entry.
5. Prior to filing Intent, prepare a proposed plugging plan in case well is D & A, then obtain approval of plan when calling district office prior to setting surface pipe.
6. Submit plugging report (CP-4) to K.C.C. after plugging is completed.
7. Obtain an approved injection docket number before disposing of salt water.
8. Notify K.C.C. within 10 days when injection commences or termination.
9. If an alternate 2 completion, cement in the production pipe from below any usable water to surface within 120 days of spud date.

**A Regular Section of Land**  
1 Mile = 5,280 Ft.

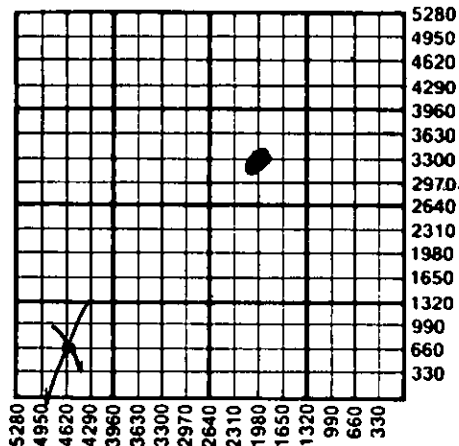

RECEIVED  
STATE CORPORATION COMMISSION  
JUN 23 1968  
CONSERVATION DIVISION  
Wichita, Kansas

State Corporation Commission of Kansas  
Conservation Division  
200 Colorado Derby Building  
Wichita, Kansas 67202-1212  
(316) 263-3238