

AFFIDAVIT AND COMPLETION FORM

ACO-1

This form must be filed in triplicate with the Kansas Corporation Commission, 200 Colorado Derby Building, Wichita, Kansas 67202, within five days after the completion of the well, regardless of how the well was completed. Circle one: Oil, gas, dry, SWD, OWWO, injection. Please type. Complete ALL sections. Applications must be filed for dual completion, commingling, salt water disposal and injection. Attach wireline logs (i.e. electrical log, sonic log, gamma ray neutron log, etc.) KCC#-(316) 263-3238.


OPERATOR R P NIXON OPERATIONS API NO. 15-051-22,469-0000
 ADDRESS 207 W 12TH COUNTY ELLIS
HAYS KS 67601 FIELD HERZOG
 **CONTACT PERSON DAN A NIXON LEASE P BRAUN
 PHONE 913-628-3834

PURCHASER CLEAR CREEK INC WELL NO. 2
 ADDRESS P O BOX 1045 WELL LOCATION C S/2 S/2 NW/4
MCPHERSON KS 67460 330 Ft. from SOUTH Line and
660 Ft. from WEST Line of
 the NW/4 SEC. 32 TWP. 13S RGE. 16W

DRILLING CONTRACTOR JAY-LAN CORPORATION
 ADDRESS 207 W 12TH
HAYS KS 67601

PLUGGING CONTRACTOR NONE
 ADDRESS _____

TOTAL DEPTH 3493' RTD _____ PBDT _____
 SPUD DATE 6-29-81 DATE COMPLETED 7-6-81
 ELEV: GR 1927' DF _____ KB 1933'

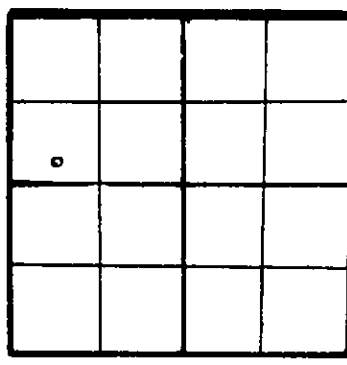

WELL PLAT
 (Quarter) or (Full) Section - Please indicate.

KCC
 KGS
 MISC. _____

DRILLED WITH ~~CABLE~~ (ROTARY) ~~AND~~ TOOLS NEW / (Used) casing.
 Report of all strings set - surface, intermediate, production, etc.

Purpose of string	Size hole drilled	Size casing set (in O.D.)	Weight lbs./ft.	Setting depth	Type cement	Sacks	Type and percent additives
SURFACE	12 3/4	8 5/8		185'	COMMON	135	
PRODUCTION	7 7/8	4 1/2"		3492	COMMON	125	10% salt

LINER RECORD			PERFORATION RECORD		
Top, ft.	Bottom, ft.	Sacks cement	Shfts per ft.	Size & type	Depth interval
			1	LE	3285, 3273, 3259
TUBING RECORD			1	LE	3232, 3214, 3185
Size 2 3/8	Setting depth 3461.58	Packer set at NA	2	LE gun	3398, 3367, 3351, 3184, 86, 3213-15

ACID, FRACTURE, SHOT, GRANT RECORD	STATE RECEIVED	DATE	DEPTH INTERVAL TREATED
Amount and kind of material used	3272-74,	3231-33, 3258-60	
2250 gals 28% acid	3284-86,	3350-52, 3366-68	3397-99
2250 gals 28% acid			3285, 3273, 3259
			3232, 3214, 3185

FEB 17 1982
 CONSERVATION DIVISION
 Wichita Kansas

TEST DATE:		PRODUCTION	
Date of first production <u>9-11-81</u>	Producing method (flowing, pumping, gas lift, etc.) <u>PUMPING</u>	A.P.I. Gravity _____	
RATE OF PRODUCTION PER 24 HOURS	Oil <u>15bb1s</u> bbls.	Gas _____ MCF	Water <u>70bb1s</u> bbls.
Disposition of gas (vented, used on lease or sold) _____		Producing interval (s) <u>SEE ABOVE</u>	

** The person who can be reached by phone regarding any questions concerning this information.
 A witnessed initial test by the Commission is required if the well produces more than 25 BOPD or is located in a Basic Order Pool.

Name of lowest fresh water producing stratum _____ Depth _____
 Estimated height of cement behind pipe 800'

WELL LOG

Show all important zones of porosity and contents thereof; cored intervals, and all drill-stem tests, including depth interval tested, cushion used, time tool open, flowing and shut-in pressures, and recoveries.

SHOW GEOLOGICAL MARKERS, LOGS RUN, OR OTHER DESCRIPTIVE INFORMATION.

FORMATION DESCRIPTION, CONTENTS, ETC.	TOP	BOTTOM	NAME	DEPTH
FORMATION TOPS:	SAMPLE	LOG	LOG MINUS DATUM	
ANHYDRITE TOP (DRILLERS)	1045	1048	+885	
ANHYDRITE BASE (DRILLERS)	N/A	1088	+845	
TOPEKA	2929	2918	-985	
HEEBNER	3150	3138	-1205	
TORONTO	3168	3156	-1223	
LANSING	3193	3182	-1249	
BASE OF KANSAS CITY	3432	3420	-1487	
CONGLOMERATE	3459	3448	-1515	
ARBUCKLE	NONE			
TOTAL DEPTH	3504	3493	-1560	

USE ADDITIONAL SHEETS, IF NECESSARY, TO COMPLETE WELL RECORD.

A F F I D A V I T

STATE OF KANSAS, COUNTY OF ELLIS SS,

DAN A NIXON OF LAWFUL AGE, BEING FIRST DULY SWORN UPON HIS OATH, DEPOSES AND SAYS:

THAT HE IS A GEOLOGIST FOR R P NIXON OPERATIONS OPERATOR OF THE P BRAUN LEASE, AND IS DULY AUTHORIZED TO MAKE THIS AFFIDAVIT FOR AND ON BEHALF OF SAID OPERATOR, THAT WELL NO. 2 ON SAID LEASE HAS BEEN COMPLETED AS OF THE 11 DAY OF SEPTEMBER 1981, AND THAT ALL INFORMATION ENTERED HEREIN WITH RESPECT TO SAID WELL IS TRUE AND CORRECT.

FURTHER AFFIANT SAITH NOT.

(S) *Dan A Nixon*

SUBSCRIBED AND SWORN TO BEFORE ME THIS 11 DAY OF FEBRUARY 1982

Maree N Stefan
 NOTARY PUBLIC

MY COMMISSION EXPIRES: 7-15-84

MAREE N STEFAN

