

CARD MUST BE TYPED

State of Kansas
NOTICE OF INTENTION TO DRILL
(see rules on reverse side)

CARD MUST BE SIGNED

Starting Date: 2 20 85
month day year

API Number 15- 101-21,132-00-00

OPERATOR: License # 9067
Name DaMar Resources, Inc.
Address P. O. Box 70
City/State/Zip Hays, KS 67601
Contact Person Daniel F. Schippers
Phone (913) 625-0020

N/2 SW NW Sec. 20 Twp. 16 S, Rge. 28 East West
(location)

3630 Ft North from Southeast Corner of Section
4620 Ft West from Southeast Corner of Section
(Note: Locate well on Section Plat on reverse side)

CONTRACTOR: License # 5829
Name Aldebaran Drilling Co., Inc.
City/State Wichita, KS 67207

Nearest lease or unit boundary line 660 feet.
County Lane

Lease Name Tillotson Well# 2

Domestic well within 330 feet: yes no

Municipal well within one mile: yes no

Well Drilled For: Well Class: Type Equipment:
 Oil Swd Infield Mud Rotary
 Gas Inj Pool Ext. Air Rotary
 OWWO Expl Wildcat Cable

Depth to Bottom of fresh water 120 feet

Lowest usable water formation Dakota

Depth to Bottom of usable water 1100 feet

Surface pipe by Alternate: 1 2

Surface pipe to be set 240 feet

Conductor pipe if any required none feet

Ground surface elevation 2740 est. feet MSL

This Authorization Expires 8-14-85

Approved By 2-14-85 *[Signature]*

If OWWO: old well info as follows:

Operator

Well Name

Comp Date Old Total Depth

Projected Total Depth 4600 feet

Projected Formation at TD Mississippi

Expected Producing Formations Lansing

I certify that we will comply with K.S.A. 55-101, et seq., plus eventually plugging hole to K.C.C. specifications.

Date 2/12/85 Signature of Operator or Agent *[Signature]*

Title President

Form C-1 4/84

MHC/UDHE 2-14-85


Must be filed with the K.C.C. five (5) days prior to commencing well
This card void if drilling not started within six (6) months of date received by K.C.C.

RECEIVED
STATE CORPORATION COMMISSION

Important procedures to follow:

FEB 14 1977

A Regular Section of Land
1 Mile = 5,280 Ft.

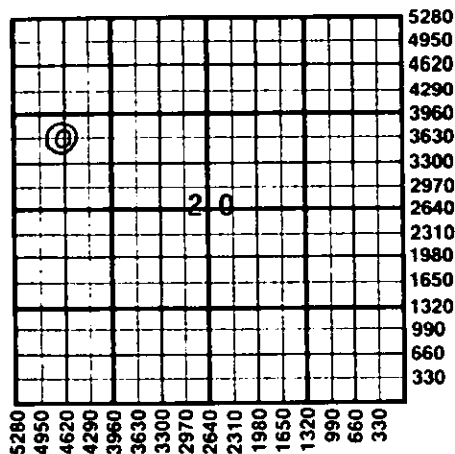

1. Notify District office before setting surface casing.
2. Set surface casing by circulating cement to the top.
3. File completion forms ACO-1 with K.C.C. within 90 days of well completion, following instructions on ACO-1, side 1, and including copies of wireline logs.
4. Notify District office 48 hours prior to old well workover or re-entry.
5. Prior to plugging, prepare a plugging plan, then obtain agreement from the appropriate district office for an approved plugging plan.
6. Submit plugging report (CP-4) to K.C.C. after plugging is completed.
7. Obtain an approved injection docket number before disposing of salt water.
8. Notify K.C.C. within 10 days when injection commences or terminates.
9. If an alternate 2 completion, cement in the production pipe from below any usable water to surface within 120 days of spud date.

CONSERVATION DIVISION
Wichita, Kansas

State Corporation Commission of Kansas
Conservation Division
200 Colorado Derby Building
Wichita, Kansas 67202
(316) 263-3238