

CARD MUST BE TYPED

State of Kansas

CARD MUST BE SIGNED

NOTICE OF INTENTION TO DRILL

(see rules on reverse side)

Starting Date 2 17 86
month day yearOPERATOR: License # 5123
Name Pickrell Drilling Company, Inc.
Address 110 N. Market, Suite 205
City/State/Zip Wichita, Kansas 67202
Contact Person Jay McNeil
Phone 262-8427CONTRACTOR: License # 5123
Name Pickrell Drilling Company, Inc.
City/State Wichita, KansasWell Drilled For: Well Class: Type Equipment:
☒ Oil ☐ SWD ☐ Infield ☒ Mud Rotary
☐ Gas ☐ Inj ☐ Pool Ext. ☐ Air Rotary
☐ OWWO ☐ Expl ☒ Wildcat ☐ Cable

If OWWO: old well info as follows:

Operator
Well Name
Comp Date Old Total Depth

I certify that well will comply with K.S.A. 55-101, et seq., plus eventually plugging hole to KCC specifications.

cementing will be done immediately upon setting production casing

Date 2-13-86 Signature of Operator or Agent

For KCC Use:

Conductor Pipe Required feet; Minimum Surface Pipe Required 200 feet per Alt. 1

This Authorization Expires 5-13-86 Approved By 2-13-86

API Number 15- 101-21,292-00-00

SW NE NW Sec 9 Twp 16 S. Rg. 28 East
4290 West
3630 Ft. from South Line of Section
Ft. from East Line of Section

(Note: Locate well on Section Plat on reverse side)

Nearest lease or unit boundary line 990 feet
County Lane
Lease Name Walton Well # 1-B
Ground surface elevation 2610 feet MSL
Domestic well within 330 feet: yes ☒ no
Municipal well within one mile: yes ☒ no
Surface pipe by Alternate: 1 2 ☒
Depth to bottom of fresh water 140
Depth to bottom of usable water 1000
Surface pipe planned to be set 200+
Projected Total Depth 4550 feet
Formation Mississippi

Roth/ROE


Title Chief Geologist

Must be filed with the K.C.C. five (5) days prior to commencing well
This card void if drilling not started within six (6) months of date received by K.C.C.

Important procedures to follow:

1. Notify District office before setting surface casing.
2. Set surface casing by circulating cement to the top.
3. File completion forms ACO-1 with K.C.C. within 90 days of well completion, following instructions on ACO-1, side 1, and including copies of wireline logs.
4. Notify District office 48 hours prior to old well workover or re-entry.
5. Prior to filing Intent, prepare a proposed plugging plan in case well is D & A, then obtain approval of plan when calling district office prior to setting surface pipe.
6. Submit plugging report (CP-4) to K.C.C. after plugging is completed.
7. Obtain an approved injection docket number before disposing of salt water.
8. Notify K.C.C. within 10 days when injection commences or terminates.
9. If an alternate 2 completion, cement in the production pipe from below any usable water to surface within 120 days of spud date.

A Regular Section of Land
1 Mile = 5,280 Ft.

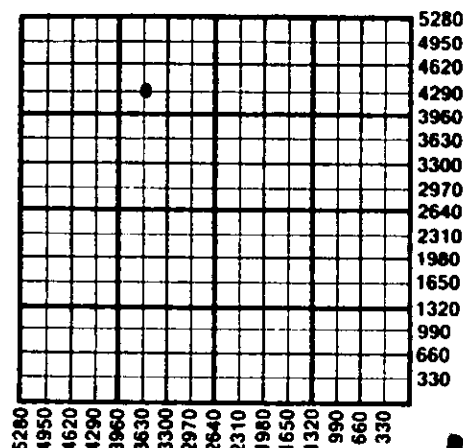

RECEIVED
STATE CORPORATION COMMISSION

FEB 13 1988

CONSERVATION DIVISION
Wichita, Kansas

State Corporation Commission of Kansas
Conservation Division
200 Colorado Derby Building
Wichita, Kansas 67202
(316) 263-3238