

CARD MUST BE TYPED

State of Kansas  
**NOTICE OF INTENTION TO DRILL**

CARD MUST BE SIGNED

(see rules on reverse side)

Starting Date: ..... 12 ..... 20 ..... 1984  
month day year

API Number 15- 101-21,109-00-00

OPERATOR: License # ..... 6113

NW ..... NW NE Sec 6 Twp 16 S. Rge 28  
(location)  East  West

Name ..... Landmark Oil Exploration, Inc.

Address ..... 105 S. Broadway, Suite 1040

City/State/Zip ..... Wichita, Kansas 67202

Contact Person ..... Jeffrey R. Wood

Phone ..... (316) 265-8181

..... 4950 Ft North from Southeast Corner of Section

..... 2310 Ft West from Southeast Corner of Section

(Note: Locate well on Section Plat on reverse side)

CONTRACTOR: License # ..... 5420

Nearest lease or unit boundary line ..... 330 feet.

County ..... Laba

Lease Name ..... James "A" Well# 1-6

Domestic well within 330 feet:  yes  no

Municipal well within one mile:  yes  no

Name ..... White & Ellis Drilling, Inc.

City/State ..... Wichita, Kansas 67202

Well Drilled For: Well Class: Type Equipment:

Oil  Swd  Infield  Mud Rotary

Gas  Inj  Pool Ext.  Air Rotary

OWWO  Expl  Wildcat  Cable

Depth to Bottom of fresh water ..... 100 feet

Lowest usable water formation ..... Dakota

Depth to Bottom of usable water ..... 1100 feet

Surface pipe by Alternate: 1  2

Surface pipe to be set ..... 325 feet

Conductor pipe if any required ..... feet

Ground surface elevation ..... 2511.61 feet MSI.

This Authorization Expires ..... 6-18-85

Approved By ..... 12-18-84

If OWWO: old well info as follows:

Operator .....

Well Name .....

Comp Date ..... Old Total Depth .....


Projected Total Depth ..... 4500 feet

Projected Formation at TD ..... Mississippian

Expected Producing Formations ..... Lansing

I certify that we will comply with K.S.A. 55-101, et seq., plus eventually plugging hole to K.C.C. specifications.

Date ..... 12-18-84 Signature of Operator or Agent

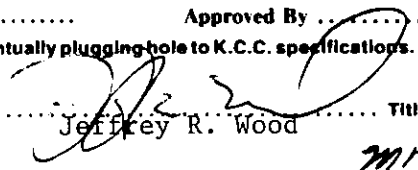  
Jeffrey R. Wood

Title ..... President


MHC/KDHE 12/18/84 Form C-1 4/84

RECEIVED  
STATE CORPORATION COMMISSION

Must be filed with the K.C.C. five (5) days prior to commencing well  
and void if drilling not started within six (6) months of date received by K.C.C.

DEC 1 8 1984

CONSERVATION DIVISION  
Wichita, Kansas  
A Regular Section of Land  
1 Mile = 5,280 Ft.

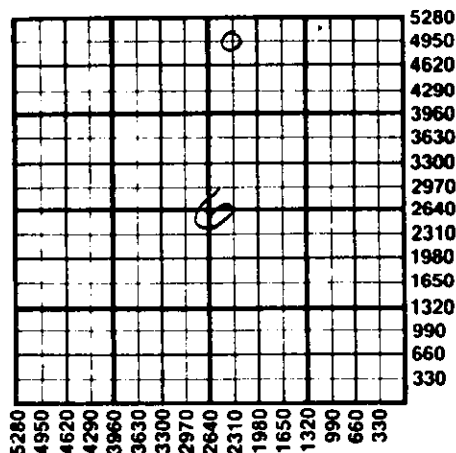

**Important procedures to follow :**

1. Notify District office before setting surface casing.
2. Set surface casing by circulating cement to the top.
3. File completion forms ACO-1 with K.C.C. within 90 days of well completion, following instructions on ACO-1, side 1, and including copies of wireline logs.
4. Notify District office 48 hours prior to old well workover or re-entry.
5. Prior to plugging, prepare a plugging plan, then obtain agreement from the appropriate district office for an approved plugging plan.
6. Submit plugging report (CP-4) to K.C.C. after plugging is completed.
7. Obtain an approved injection docket number before disposing of salt water.
8. Notify K.C.C. within 10 days when injection commences or terminates.
9. If an alternate 2 completion, cement in the production pipe from below any usable water to surface within 120 days of spud date.

State Corporation Commission of Kansas  
Conservation Division  
200 Colorado Derby Building  
Wichita, Kansas 67202  
(316) 263-3238