

CARD MUST BE TYPED

State of Kansas

CARD MUST BE SIGNED

NOTICE OF INTENTION TO DRILL

(see rules on reverse side)

Expected Spud Date: 7 10 88
month day year

API Number 15-101-21,478-00-00

OPERATOR: License # 9067 & 7245

NE/4 SW/4 NE/4 5 Sec. 16 Twp. 16 S, Rg. 28 East West

Name Damar Resources, Inc. and Texas-
El Dorado Oil Company

Address P. O. Box 70
City/State/Zip Hays, KS 67601

Contact Person D. Schippers
Phone (913) 625-0020

3630 Ft. from South Line of Section
1650 Ft. from East Line of Section

(Note: Locate well on Section Plat on reverse side)

CONTRACTOR: License # 5420

Name White & Ellis Drilling, Inc.
City/State Wichita, Kansas

Nearest lease or unit boundary line 990 feet
County Lane

Lease Name Roberts 'D' Well # 1-5

Ground surface elevation 2565 est. feet MSL

Domestic well within 330 feet: yes no

Municipal well within one mile: yes no

Well Drilled For: Well Class: Type Equipment:

Oil Storage Infield Mud Rotary
 Gas Inj Pool Ext. Air Rotary
 OWWO Expl Wildcat Cable

Depth to bottom of fresh water 100

Depth to bottom of usable water 925 / 1100

Surface pipe by Alternate: 1 2

Surface pipe planned to be set 300

Conductor pipe required N/A

Projected Total Depth 4450 feet

Formation Lans./Miss.

If OWWO: old well info as follows:

Operator

Well Name

Comp Date Old Total Depth

I certify that well will comply with K.S.A. 55-101, et seq. plus eventually plugging hole to KCC specifications.

Date 6/16/88 Signature of Operator or Agent [Signature] Title President

For KCC Use:

Conductor Pipe Required _____ feet; Minimum Surface Pipe Required 200 feet per Alt. 2


This Authorization Expires 12-23-88 Approved By PCH 6-23-88

Must be filed with the K.C.C. five (5) days prior to commencing well
This card void if drilling not started within six (6) months of date received by K.C.C.

Important procedures to follow:

1. Notify District office before setting surface casing.
2. Set surface casing by circulating cement to the top.
3. File completion forms ACO-1 with K.C.C. within 120 days of well spud date, following instructions on ACO-1, side 1, and including copies of wireline logs.
4. Notify District office 48 hours prior to old well workover or re-entry.
5. Prior to filing Intent, prepare a proposed plugging plan in case well is D & A, then obtain approval of plan when calling district office prior to setting surface pipe.
6. Submit plugging report (CP-4) to K.C.C. after plugging is completed.
7. Obtain an approved injection docket number before disposing of salt water.
8. Notify K.C.C. within 10 days when injection commences or termination.
9. If an alternate 2 completion, cement in the production pipe from below any usable water to surface within 120 days of spud date.

A Regular Section of Land
1 Mile = 5,280 Ft.

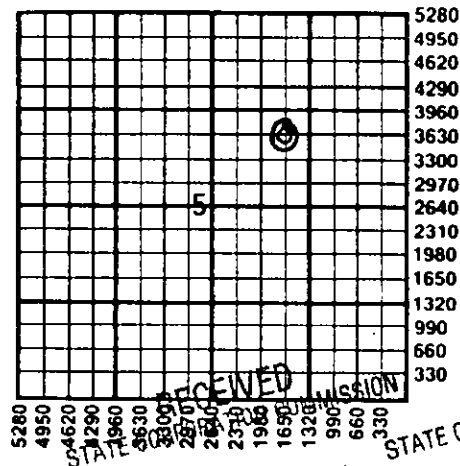

JUN 17 1988

CONSERVATION DIVISION
Wichita, Kansas

JUN

CONSERVATION DIVISION
Wichita, Kansas

State Corporation Commission of Kansas
Conservation Division
200 Colorado Derby Building
Wichita, Kansas 67202-1212
(316) 263-3235