

CARD MUST BE TYPED

State of Kansas  
**NOTICE OF INTENTION TO DRILL**  
(see rules on reverse side)

CARD MUST BE SIGNED

Starting Date: 09 20 1985  
month day year 2:45

API Number 15- 101-21,230-00-00

OPERATOR: License # 6113  
Name Landmark Oil Exploration, Inc.  
Address 105 S. Broadway, Suite 1040  
City/State/Zip Wichita, Kansas 67202  
Contact Person Jeffrey R. Wood  
Phone (316) 265-8181

150' W E/2 W/2 NW/4 Sec 29 Twp 17 S, Rge 27  East  
(location)  West

3960 Ft North from Southeast Corner of Section  
4440 Ft West from Southeast Corner of Section  
(Note: Locate well on Section Plat on reverse side)

CONTRACTOR: License # 6033  
Name Murfin Drilling Co.  
City/State Wichita, Kansas

Nearest lease or unit boundary line 840 feet.  
County Lane

Lease Name Harlamert Well# 1-29

Well Drilled For: Well Class: Type Equipment:  
 Oil  Swd  Infield  Mud Rotary  
 Gas  Inj  Pool Ext.  Air Rotary  
 OWWO  Expl  Wildcat  Cable

Domestic well within 330 feet:  yes  no  
Municipal well within one mile:  yes  no

If OWWO: old well info as follows:  
Operator  
Well Name  
Comp Date Old Total Depth  
Projected Total Depth 4700 feet  
Projected Formation at TD Mississippi  
Expected Producing Formations Lansing, Marmaton, Cherokee

Depth to Bottom of fresh water 100 feet  
Lowest usable water formation Dakota  
Depth to Bottom of usable water 1000 feet  
Surface pipe by Alternate: 1  2   
Surface pipe to be set 300 feet  
Conductor pipe if any required feet  
Ground surface elevation feet MSL.  
This Authorization Expires 3-18-86

I certify that we will comply with K.S.A. 55-101, et seq., plus eventually plugging hole to K.C.C. specifications. In the event, production casing is run, it will be cemented by Alternate II to protect the Dakota aquifer.

Date 9-18-85 Signature of Operator or Agent Jeffrey R. Wood Title President

Approved By 9-18-85 R

RCR/TKK


Must be filed with the K.C.C. five (5) days prior to commencing well  
This card void if not started within six (6) months of date received by K.C.C.

RECEIVED  
STATE CORPORATION COMMISSION

SEP 19 1985

Important procedures to follow:

A Regular Section of Land CONSERVATION DIVISION  
1 Mile = 5,280 Ft. Wichita, Kansas

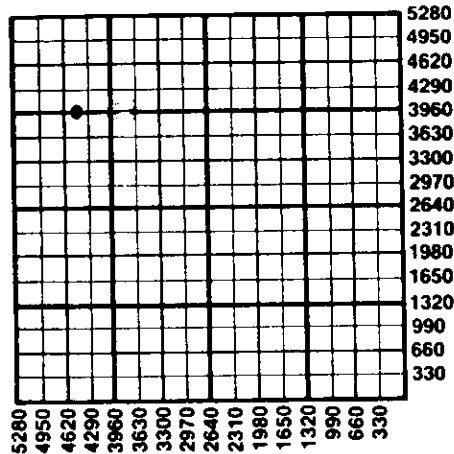

1. Notify District office before setting surface casing.
2. Set surface casing by circulating cement to the top.
3. File completion forms ACO-1 with K.C.C. within 90 days of well completion, following instructions on ACO-1, side 1, and including copies of wireline logs.
4. Notify District office 48 hours prior to old well workover or re-entry.
5. Prior to plugging, prepare a plugging plan, then obtain agreement from the appropriate district office for an approved plugging plan.
6. Submit plugging report (CP-4) to K.C.C. after plugging is completed.
7. Obtain an approved injection docket number before disposing of salt water.
8. Notify K.C.C. within 10 days when injection commences or terminates.
9. If an alternate 2 completion, cement in the production pipe from below any usable water to surface within 120 days of spud date.

State Corporation Commission of Kansas  
Conservation Division  
200 Colorado Derby Building  
Wichita, Kansas 67202  
(316) 263-3238