

CARD MUST BE TYPED

State of Kansas
NOTICE OF INTENTION TO DRILL
(see rules on reverse side)

CARD MUST BE SIGNED

Starting Date: December 6, 1984
month day year

API Number 15- 101-21, 102-00-00

OPERATOR: License # KCC 9954

SE SW 1/4 SW Sec 29, Twp 17, S, Rge 27 East West
(location)

Name L. J. Erskin Oil

Address 116 E. Long

City/State/Zip Dighton, Kansas 67839

Contact Person L. June Erskin

Phone 316-397-5316 or 397-2382

330 Ft North from Southeast Corner of Section
4600 Ft West from Southeast Corner of Section
(Note: Locate well on Section Plat on reverse side)

CONTRACTOR: License # 5829

Name Aldebaren Drilling Co.

City/State Wichita, Kansas

Nearest lease or unit boundary line 330 feet.
County Lane

Lease Name Harlamert Well# 1 Opal.

Well Drilled For: Well Class: Type Equipment:

OH Swd Infield Mud Rotary

Gas Inj Pool Ext. Air Rotary

OWWO Expl Wildcat Cable

Domestic well within 330 feet: yes no

Municipal well within one mile: yes no

Est. Total Depth: 4665 Feet

If OWWO: old well info as follows:

Operator

Well Name

Comp Date Old Total Depth

Projected Total Depth 4665 feet

Projected Formation at TD

Expected Producing Formations

Depth to Bottom of fresh water 127 feet

Lowest usable water formation Dakota

Depth to Bottom of usable water 1000 feet

Surface pipe by Alternate: 1 2 3

Surface pipe to be set 300 feet

Conductor pipe if any required

Ground surface elevation 2711 feet MSI.

This Authorization Expires 6-4-85

Approved By 12-4-84

I certify that we will comply with K.S.A. 55-101, et seq., plus eventually plugging hole to K.C.C. specifications.

Date 12/4/84 Signature of Operator or Agent

L. June Erskin

Title operator

MHC/KOHE 12/4/84

Must be filed with the K.C.C. five (5) days prior to commencing well
 This card void if drilling not started within six (6) months of date received by K.C.C.


DEC 4 1984

STATE CORPORATION COMMISSION

RECEIVED

A Regular Section of Land

1 Mile = 5,280 Ft.

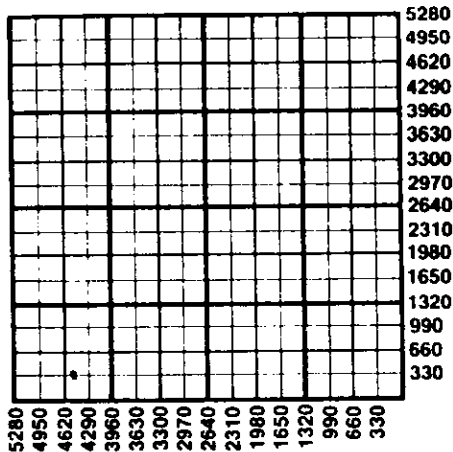

Important procedures to follow :

1. Notify District office before setting surface casing.
2. Set surface casing by circulating cement to the top.
3. File completion forms ACO-1 with K.C.C. within 90 days of well completion, following instructions on ACO-1, side 1, and including copies of wireline logs.
4. Notify District office 48 hours prior to old well workover or re-entry.
5. Prior to plugging, prepare a plugging plan, then obtain agreement from the appropriate district office for an approved plugging plan.
6. Submit plugging report (CP-4) to K.C.C. after plugging is completed.
7. Obtain an approved injection docket number before disposing of salt water.
8. Notify K.C.C. within 10 days when injection commences or terminates.
9. If an alternate 2 completion, cement in the production pipe from below any usable water to surface within 120 days of spud date.

State Corporation Commission of Kansas
 Conservation Division
 200 Colorado Derby Building
 Wichita, Kansas 67202
 (316) 263-3238