

CARD MUST BE TYPED

State of Kansas
NOTICE OF INTENTION TO DRILL

CARD MUST BE SIGNED

(see rules on reverse side)

Starting Date: November 26, 1984
month day year

API Number 15- 101-21,094-00-00

OPERATOR: License # 4054
Name C.K.K. Exploration, Inc.
Address P.O. Box 7339
City/State/Zip Wichita, Kansas 67207-0339
Contact Person C.K. Morrison
Phone (316) 788-5160

C. SW. SW. NE Sec 28, Twp 17, S, Rge 27
(location) East West

2970 Ft North from Southeast Corner of Section
2310 Ft West from Southeast Corner of Section
(Note: Locate well on Section Plat on reverse side)

CONTRACTOR: License # 5138
Name Cougar Drilling Co., Inc.
City/State Wichita, Kansas

Nearest lease or unit boundary line 330 feet
County Lane

Lease Name Hanks Well # 1

Domestic well within 330 feet: yes no + 120' deep

Municipal well within one mile: yes no

Well Drilled For: Well Class: Type Equipment:
 Oil Swd Infield Mud Rotary
 Gas Inj Pool Ext. Air Rotary
 OWWO Expl Wildcat Cable

Depth to Bottom of fresh water 120 feet

Lowest usable water formation Dakota

Depth to Bottom of usable water 1000 feet

Surface pipe by Alternate: 1 2

Surface pipe to be set 320 feet

Conductor pipe if any required None feet

Ground surface elevation 2698 feet MSI

This Authorization Expires 5-21-85

Approved By 11-21-84

If OWWO: old well info as follows:

Operator
Well Name
Comp Date Old Total Depth
Projected Total Depth 4650 feet
Projected Formation at TD Mississippian
Expected Producing Formations Lansing/Kansas City

I certify that we will comply with K.S.A. 55-101, et seq., plus eventually plugging hole to K.C.C. specifications.

Date 11/21/84 Signature of Operator or Agent

Charles Morrison

Title President

MHC/KANE 11/21/84


Must be filed with the K.C.C. five (5) days prior to commencing well
 This card void if drilling not started within six (6) months of date received by K.C.C.

RECEIVED
 STATE CORPORATION COMMISSION

Important procedures to follow

NOV 21 1984

A Regular Section of Land
1 Mile = 5,280 Ft.

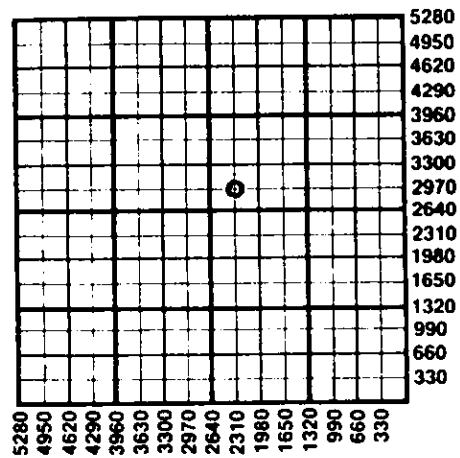

CONSERVATION DIVISION
 Wichita, Kansas

1. Notify District office before setting surface casing.
2. Set surface casing by circulating cement to the top.
3. File completion forms ACO-1 with K.C.C. within 90 days of well completion, following instructions on ACO-1, side 1, and including copies of wireline logs.
4. Notify District office 48 hours prior to old well workover or re-entry.
5. Prior to plugging, prepare a plugging plan, then obtain agreement from the appropriate district office for an approved plugging plan.
6. Submit plugging report (CP-4) to K.C.C. after plugging is completed.
7. Obtain an approved injection docket number before disposing of salt water.
8. Notify K.C.C. within 10 days when injection commences or terminates.
9. If an alternate 2 completion, cement in the production pipe from below any usable water to surface within 120 days of spud date.

State Corporation Commission of Kansas
 Conservation Division
 200 Colorado Derby Building
 Wichita, Kansas 67202
 (316) 263-3238