

CARD MUST BE TYPED

State of Kansas  
NOTICE OF INTENTION TO DRILL

CARD MUST BE SIGNED

(see rules on reverse side)

Starting Date: 8 03 84  
month day year

API Number 15- 101-21,018-00-00

OPERATOR: License # 6390, 9067 100' SE N/2 NW SW Sec. 28. Twp. 17. S. Rge. 27.  East  West

Name McDonald-Wallace Pet. and DaMar Resources, Inc. (Location)

Address P.O. Box 70 2260 Ft North from Southeast Corner of Section

City/State/Zip Hays, KS 67601 4570 Ft West from Southeast Corner of Section

Contact Person D. Schippers (Note: Locate well on Section Plat on reverse side)

Phone (913) 625-0020 Nearest lease or unit boundary line 380 feet.

CONTRACTOR: License # 5829 County Lane

Name Aldebaran Drilling Co. Lease Name Scott Well# 1

City/State Wichita, KS 67207

Well Drilled For: Well Class: Type Equipment: Domestic well within 330 feet:  yes  no

Oil  Swd  Infield  Mud Rotary Municipal well within one mile:  yes  no

Gas  Inj  Pool Ext.  Air Rotary

OWWO  Expl  Wildcat  Cable

If OWWO: old well info as follows: Depth to Bottom of fresh water 120 feet

Operator Well Name Surface pipe by Alternate: 1  2

Comp Date Old Total Depth Surface pipe to be set 400 feet

Projected Total Depth 4650 feet Conductor pipe if any required none feet

Projected Formation at TD Cherokee Ground surface elevation 2700 est. feet MSI.

Expected Producing Formations Lansing This Authorization Expires 1/27/85

Approved By 7/27/84 R

I certify that we will comply with K.S.A. 55-101, et seq., plus eventually plugging hole to K.C.C. specifications.

Date 7/27/84 Signature of Operator or Agent Title President


MHC/KOHE 7/27/84

Must be filed with the K.C.C. five (5) days prior to commencing well  
 This card void if drilling not started within six (6) months of date received by K.C.C.

**Important procedures to follow:**

**A Regular Section of Land  
 1 Mile = 5,280 Ft.**

1. Notify District office before setting surface casing.
  2. Set surface casing by circulating cement to the top.
  3. File completion forms ACO-1 with K.C.C. within 90 days of well completion, following instructions on ACO-1, side 1, and including copies of wireline logs.
  4. Notify District office 48 hours prior to old well workover or re-entry.
  5. Prior to plugging, prepare a plugging plan, then obtain agreement from the appropriate district office for an approved plugging plan.
  6. Submit plugging report (CP-4) to K.C.C. after plugging is completed.
  7. Obtain an approved injection docket number before disposing of salt water.
2. Notify K.C.C. within 10 days when injection commences or terminates.  
 2. Complete 2 completion, cement in the production pipe from below any usable water to surface within 120 days of spud date.

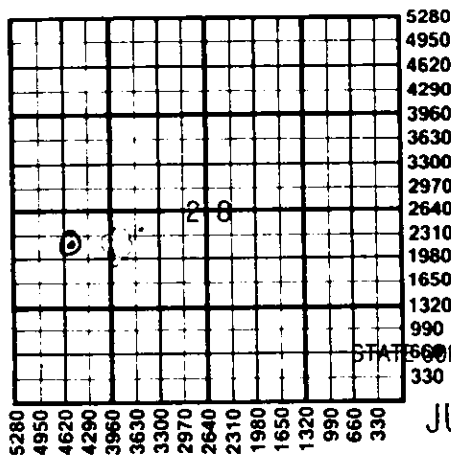

RECEIVED  
 STATE CORPORATION COMMISSION

JUL 27 1984

CONSERVATION DIVISION  
 Wichita, Kansas

State Corporation Commission of Kansas  
 Conservation Division  
 200 Colorado Derby Building  
 Wichita, Kansas 67202  
 (316) 263-3238