

CARD MUST BE TYPED

State of Kansas
NOTICE OF INTENTION TO DRILL
(see rules on reverse side)

CARD MUST BE SIGNED

Starting Date: February 3, 1986
month day year 11:00

API Number 15- 101-21,285-00-00

OPERATOR: License # ... 4629

..... NW, SW, NE ... Sec . 27, Twp 17. S, Rge . 27. East
(location) West

Name .. BRITO OIL COMPANY, INC.

Address 107 N. Market, Suite 414

3630 Ft North from Southeast Corner of Section

City/State/Zip Wichita, KS 67202

2310 Ft West from Southeast Corner of Section

Contact Person Raul F. Brito

(Note: Locate well on Section Plat on reverse side)

Phone ... 316.685-3365

Nearest lease or unit boundary line 330 feet.

CONTRACTOR: License # 5104

County Lane

Name .. BLUE GOOSE DRILLING COMPANY, INC.

Lease Name Murma Well# 1

City/State Great Bend, KS 67530

Domestic well within 330 feet : yes no

Well Drilled For: Well Class: Type Equipment:

Municipal well within one mile : yes no

Oil Swd Infield Mud Rotary

Depth to Bottom of fresh water ~ 75 feet

Gas Inj Pool Ext. Air Rotary

Lowest usable water formation .. Dakota

OWWO Expl Wildcat Cable

Depth to Bottom of usable water 1000 feet

If OWWO: old well info as follows:

Surface pipe by Alternate : 1 2

Operator

Surface pipe to be set .. 350 feet

Well Name

Conductor pipe if any required feet

Comp Date Old Total Depth

Ground surface elevation feet MSI.

Projected Total Depth 4650 feet

This Authorization Expires 7-31-86

Projected Formation at TD Mississippian

Approved By 1-31-86

Expected Producing Formations Lansing


I certify that we will comply with K.S.A. 55-101, et seq., plus eventually plugging holes to K.C.C. specifications.

Date .. 1/29/86 Signature of Operator or Agent

Title .. President

Must be filed with the K.C.C. five (5) days prior to commencing well
 This card void if drilling not started within six (6) months of date received by K.C.C.

A Regular Section of Land
 1 Mile = 5,280 Ft.

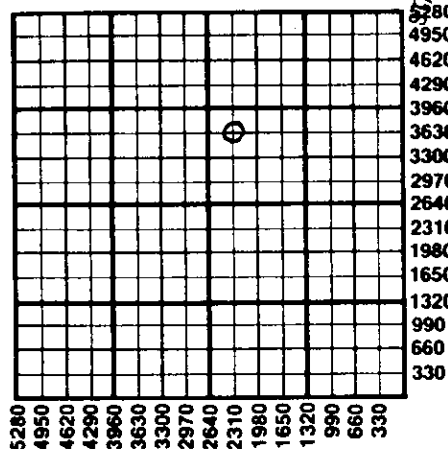

RECEIVED
 STATE CORPORATION COMMISSION

JAN 31 1996

CONSERVATION DIVISION
 Wichita, Kansas

Important procedures to follow :

1. Notify District office before setting surface casing.
2. Set surface casing by circulating cement to the top.
3. File completion forms ACO-1 with K.C.C. within 90 days of well completion, following instructions on ACO-1, side 1, and including copies of wireline logs.
4. Notify District office 48 hours prior to old well workover or re-entry.
5. Prior to plugging, prepare a plugging plan, then obtain agreement from the appropriate district office for an approved plugging plan.
6. Submit plugging report (CP-4) to K.C.C. after plugging is completed.
7. Obtain an approved injection docket number before disposing of salt water.
8. Notify K.C.C. within 10 days when injection commences or terminates.
9. If an alternate 2 completion, cement in the production pipe from below any usable water to surface within 120 days of spud date.

State Corporation Commission of Kansas
Conservation Division
200 Colorado Derby Building
Wichita, Kansas 67202
(316) 263-3238