

CARD MUST BE TYPED

State of Kansas  
**NOTICE OF INTENTION TO DRILL**  
(see rules on reverse side)

CARD MUST BE SIGNED

Starting Date: 3 5 85  
month day year

API Number IS- 101-21,137-00-00

OPERATOR: License # 5886  
Name Chief Drilling Co., Inc.  
Address 905 Century Plaza  
City/State/Zip Wichita, Ks. 67202  
Contact Person Douglas W. Thimesch  
Phone 316-262-3791

SW. NW. SE... Sec. 14. Twp 17.. S. Rge 27..  East  
(location)  West

1650... Ft North from Southeast Corner of Section  
2210... Ft West from Southeast Corner of Section  
(Note: Locate well on Section Plat on reverse side)

CONTRACTOR: License # 5883  
Name Warrior Drilling Co., Rig #2  
City/State Wichita, Ks. 67202

Nearest lease or unit boundary line 330 feet.  
County Lane

Lease Name Hagans Well# 1

Well Drilled For: Well Class: Type Equipment:  
 Oil  Swd  Infield  Mud Rotary  
 Gas  Inj  Pool Ext.  Air Rotary  
 OWWO  Expl  Wildcat  Cable

Domestic well within 330 feet:  yes  no  
Municipal well within one mile:  yes  no

If OWWO: old well info as follows:

Operator  
Well Name  
Comp Date Old Total Depth  
Projected Total Depth 4640 feet  
Projected Formation at TD Mississippi  
Expected Producing Formations Lansing KC

Depth to Bottom of fresh water 150! feet  
Lowest usable water formation Lower Cretaceous  
Depth to Bottom of usable water 1200! feet  
Surface pipe by Alternate: 1  2   
Surface pipe to be set 350! feet  
Conductor pipe if any required feet  
Ground surface elevation will provide feet MSL.  
This Authorization Expires 8-22-85  
Approved By 2-22-85

I certify that we will comply with K.S.A. 55-101, et seq., plus eventually plugging hole to K.C.C. specifications.

Date 2-21-85 Signature of Operator or Agent

*F.W. Shelton*  
F.W. Shelton, Jr.,


Vice President

Form C-1 4/84  
m HC/KOHE 2-22-85

Must be filed with the K.C.C. five (5) days prior to commencing well  
This card void if drilling not started within six (6) months of date received by K.C.C.

**Important procedures to follow :**

**A Regular Section of Land  
1 Mile = 5,280 Ft.**

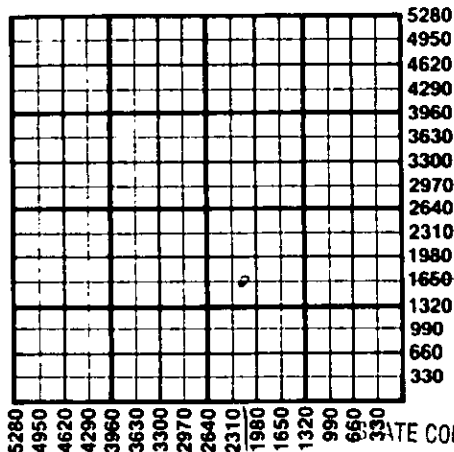

1. Notify District office before setting surface casing.
2. Set surface casing by circulating cement to the top.
3. File completion forms ACO-1 with K.C.C. within 90 days of well completion, following instructions on ACO-1, side 1, and including copies of wireline logs.
4. Notify District office 48 hours prior to old well workover or re-entry.
5. Prior to plugging, prepare a plugging plan, then obtain agreement from the appropriate district office for an approved plugging plan.
6. Submit plugging report (CP-4) to K.C.C. after plugging is completed.
7. Obtain an approved injection docket number before disposing of salt water.
8. Notify K.C.C. within 10 days when injection commences or terminates.
9. If an alternate 2 completion, cement in the production pipe from below any usable water to surface within 120 days of spud date.

RECEIVED

STATE CORPORATION COMMISSION State Corporation Commission of Kansas

FEB 22 1955

CONSERVATION DIVISION

Conservation Division  
200 Colorado Derby Building  
Wichita, Kansas 67202  
(316) 263-3238