

NOTICE OF INTENTION TO DRILL

(see rules on reverse side)

Starting Date 12 15 1986 month day year 11:38

API Number 15-101-21352-00-00

OPERATOR: License # 6113
Name Landmark Oil Exploration, Inc.
Address 110 S. Main, Suite 510
City/State/Zip Wichita, Kansas 67202
Contact Person Jeffrey R. Wood
Phone 316-265-8181

NE NW SE Sec 14 Twp 17 S, Rg 27 East West
2310 Ft. from South Line of Section
1650 Ft. from East Line of Section

(Note: Locate well on Section Plat on reverse side)

CONTRACTOR: License # 5422
Name Abercrombie Drilling, Inc.
City/State Wichita, Kansas

Nearest lease or unit boundary line 330 feet
County Lane
Lease Name Hagans Well # 1-14

Well Drilled For: Well Class: Type Equipment:
X Oil SWD Infield X Mud Rotary
Gas Inj X Pool Ext Air Rotary
OWWO Expl Wildcat Cable

Ground surface elevation feet MSL
Domestic well within 330 feet: yes X no
Municipal well within one mile: yes X no
Depth to bottom of fresh water 200
Depth to bottom of usable water 1250'
Surface pipe by Alternate: 1 2 X
Surface pipe planned to be set 250'
Conductor pipe required
Projected Total Depth 4650 feet
Formation Mississippi

If OWWO: old well info as follows:

Operator
Well Name
Comp Date Old Total Depth

I certify that well will comply with K.S.A. 55-101, et seq., plus eventually plugging hole to KCC specifications.

Date 12-12-86 Signature of Operator or Agent Robert C. Patton Title Exploration Manager

For KCC Use:

Conductor Pipe Required feet; Minimum Surface Pipe Required 250 feet per Alt.
This Authorization Expires 6-12-87 Approved By 12-12-86


Handwritten signature and initials at bottom right.

Must be filed with the K.C.C. five (5) days prior to commencing well
This card void if drilling not started within six (6) months of date received by K.C.C.

Important procedures to follow:

1. Notify District office before setting surface casing.
2. Set surface casing by circulating cement to the top.
3. File completion forms ACO-1 with K.C.C. within 90 days of well completion, following instructions on ACO-1, side 1, and including copies of wireline logs.
4. Notify District office 48 hours prior to old well workover or re-entry.
5. Prior to filing Intent, prepare a proposed plugging plan in case well is D & A, then obtain approval of plan when calling district office prior to setting surface pipe.
6. Submit plugging report (CP-4) to K.C.C. after plugging is completed.
7. Obtain an approved injection docket number before disposing of salt water.
8. Notify K.C.C. within 10 days when injection commences or terminates.

A Regular Section of Land
1 Mile = 5,280 Ft.

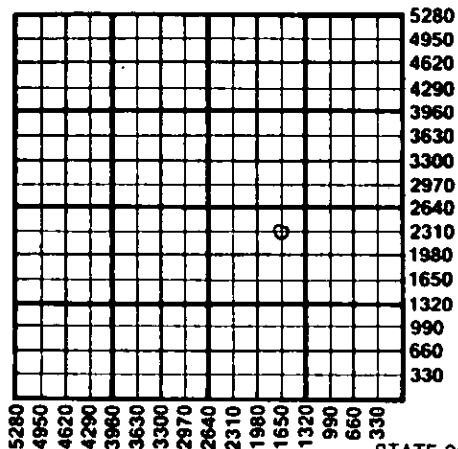

RECEIVED

STATE CORPORATION COMMISSION. If an alternate 2 completion, cement in the production pipe from any usable water to surface within 120 days of spud date.

DEC 12 1986

CONSERVATION DIVISION
Wichita, Kansas

State Corporation Commission of Kansas
Conservation Division
200 Colorado Derby Building
Wichita, Kansas 67202
(316) 263-3238